


TWP. 40S R9W

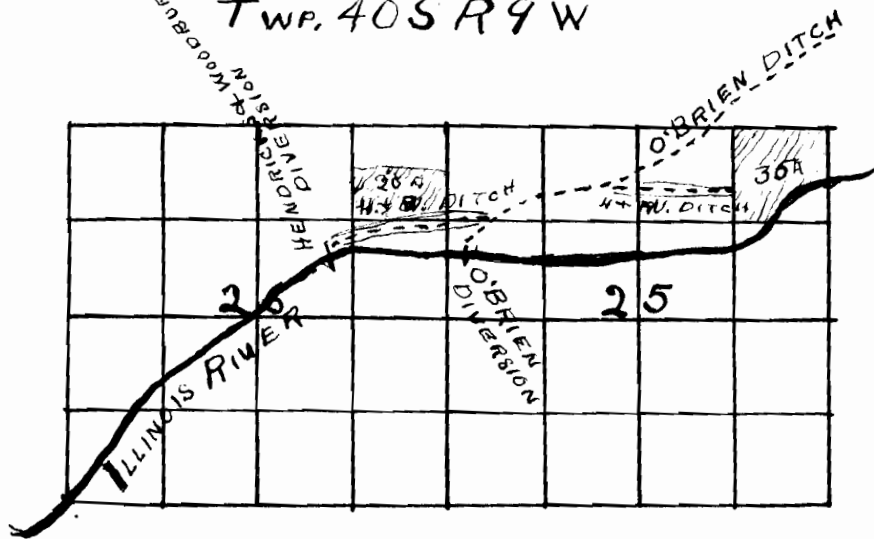

1920


Application No.

6998

Permit No.

4471

TWP. 40 S. R. 9 W. W.M.

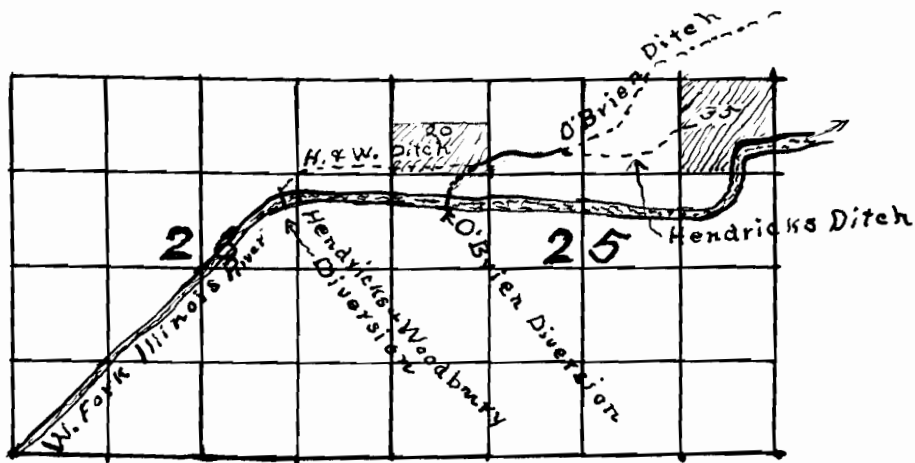

6998

4471

Amended Map.