

RECEIVED

FEB 7 1980

WATER RESOURCES DEPT
SALEM, OREGON


T25S R13W SEC 34

Scale 1" = 200'

RECEIVED

SEP 11 1979

WATER RESOURCES DEPT
SALEM, OREGON

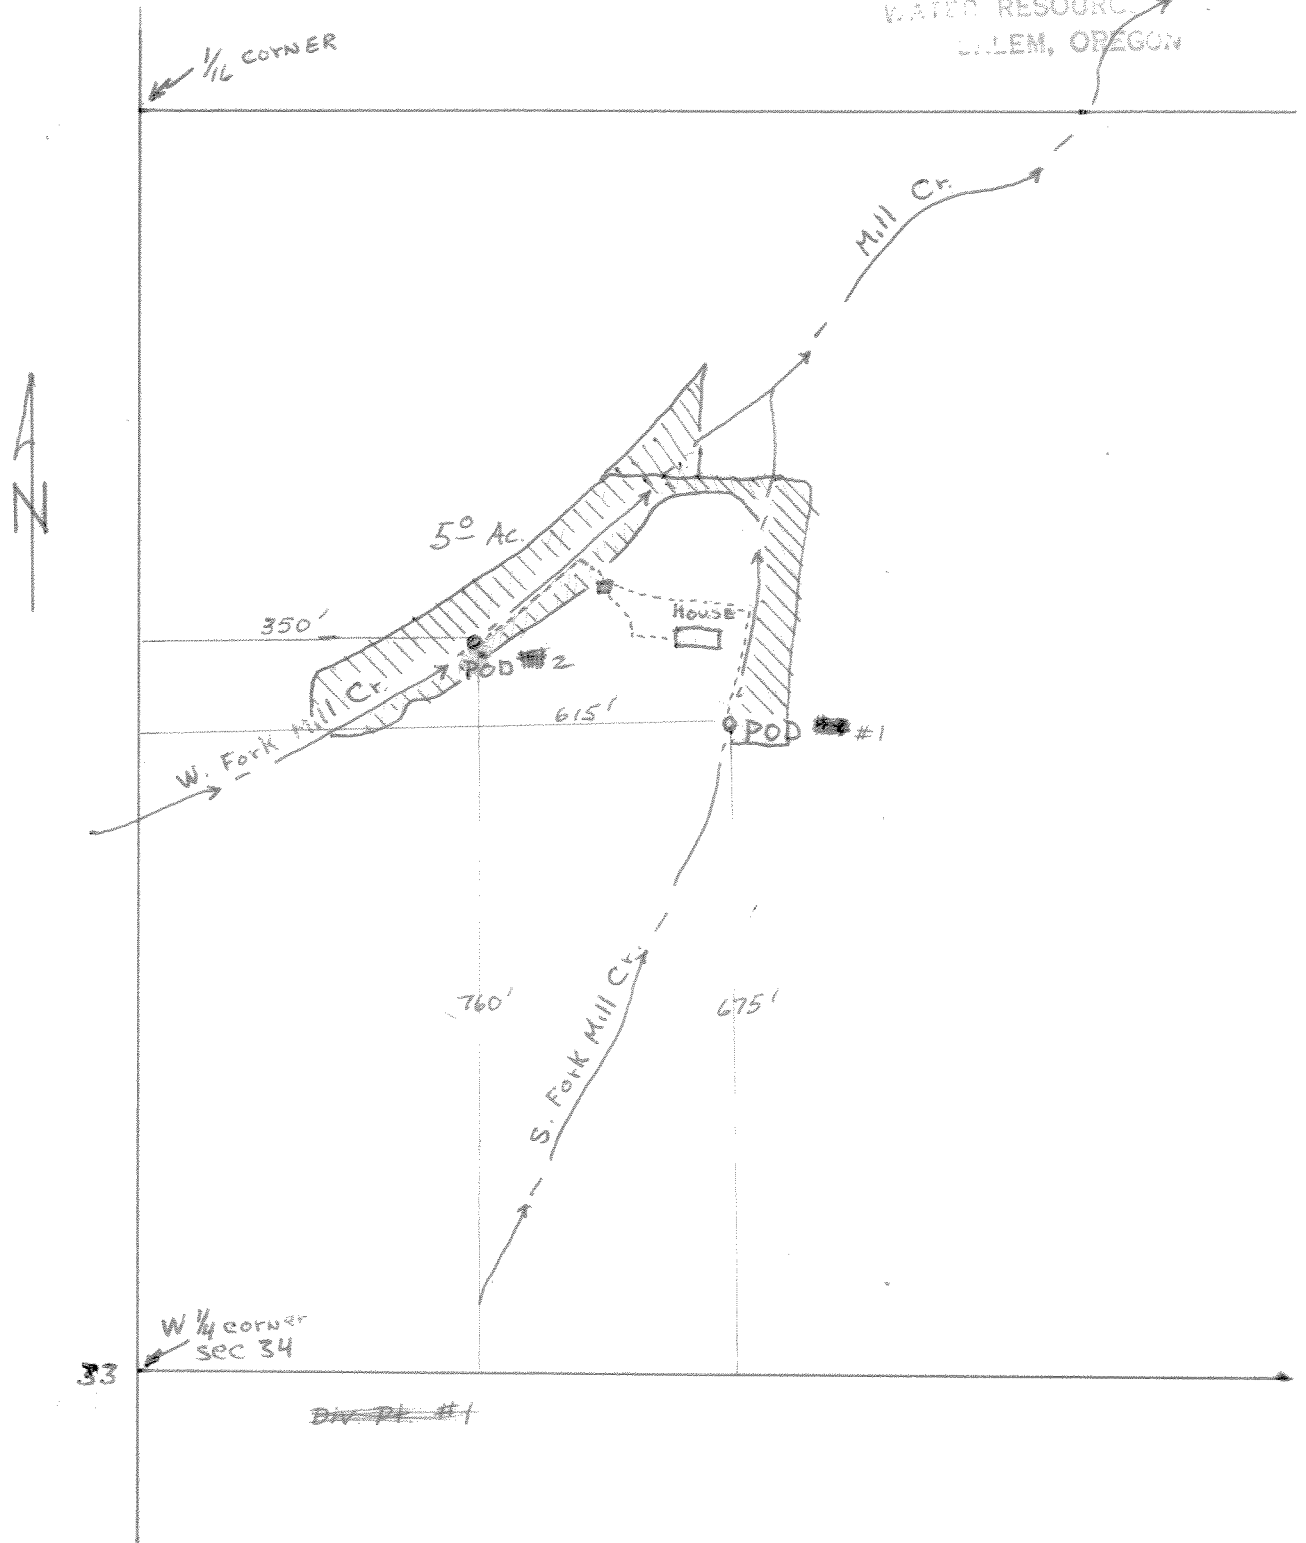

Application No.

59324

Permit No.

44710