


EXHIBIT C

T 2 N R 10 E

scale 1"=400'

RECEIVED
WATER RESOURCES DEPT.
NOV 1979

RECEIVED
WATER RESOURCES DEPT.
MAR 2 1980

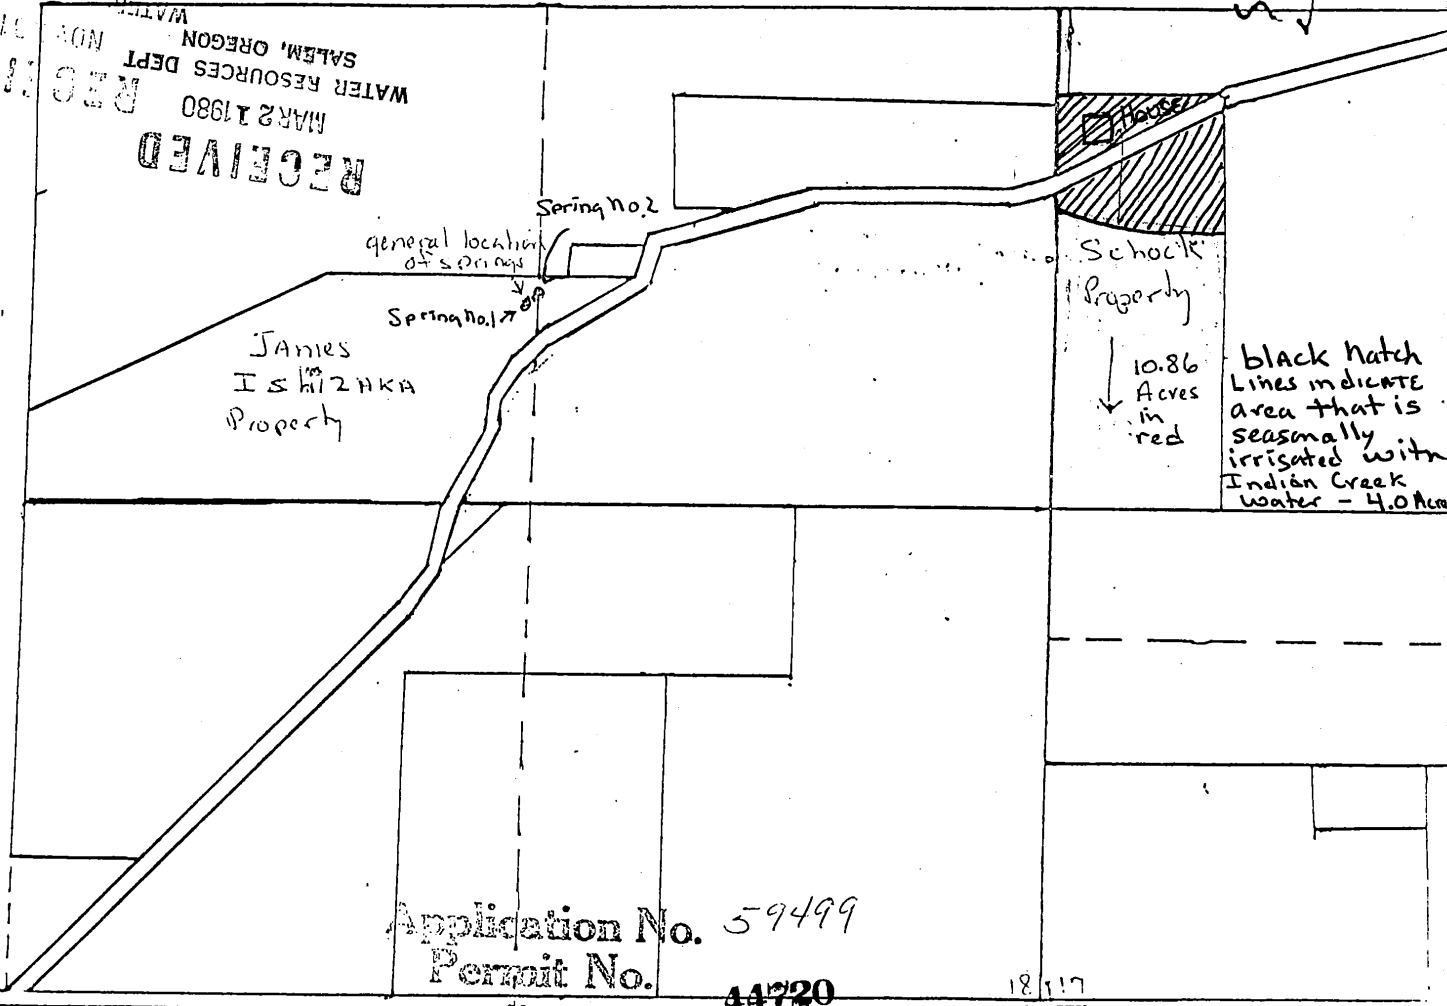

18 17
19 20