T.7S.R4W.W.M.

RECEIVED
JUN 22 1979
WATER RESOURCES DEPT.
SALEM, OREGON

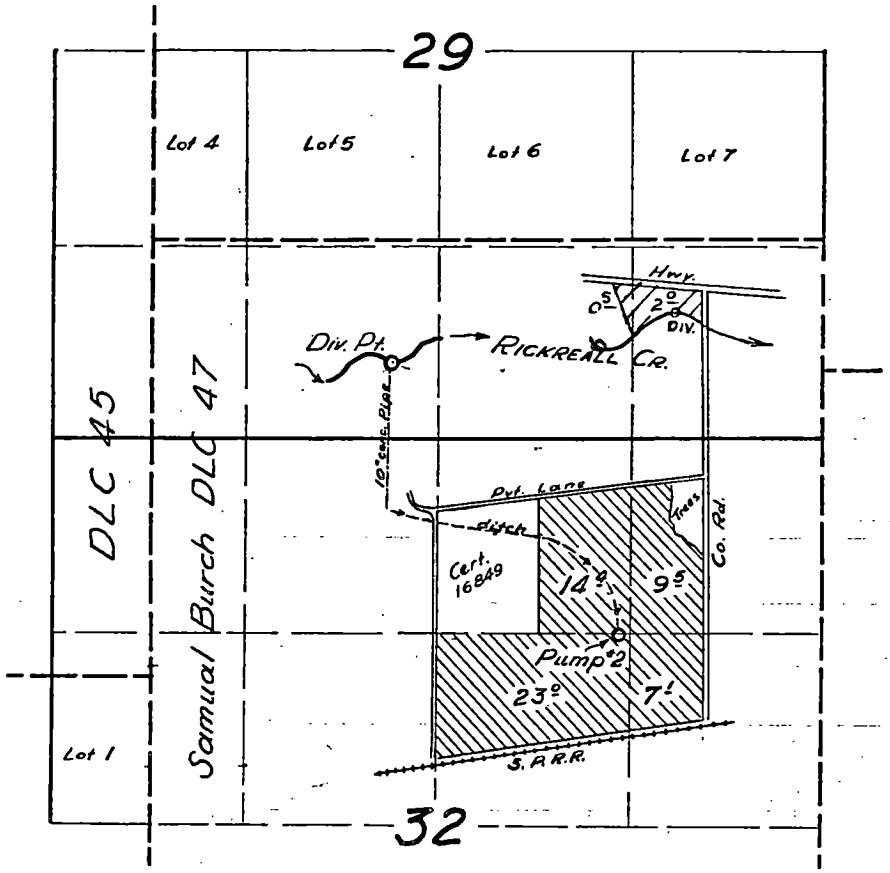

DIV: 850 ft N AND 1000 ft W FROM SE COR SEC 29

Application No. 58827
Permit No. 44726

FINAL PROOF SURVEY

UNDER

Application No. 23134 Permit No. 18419

IN NAME OF

C. BARENDECHT

Surveyed 19 Mar. 1957, by [signature]

DFP-2D-102