


T. 37S., R. 5W., W.M.

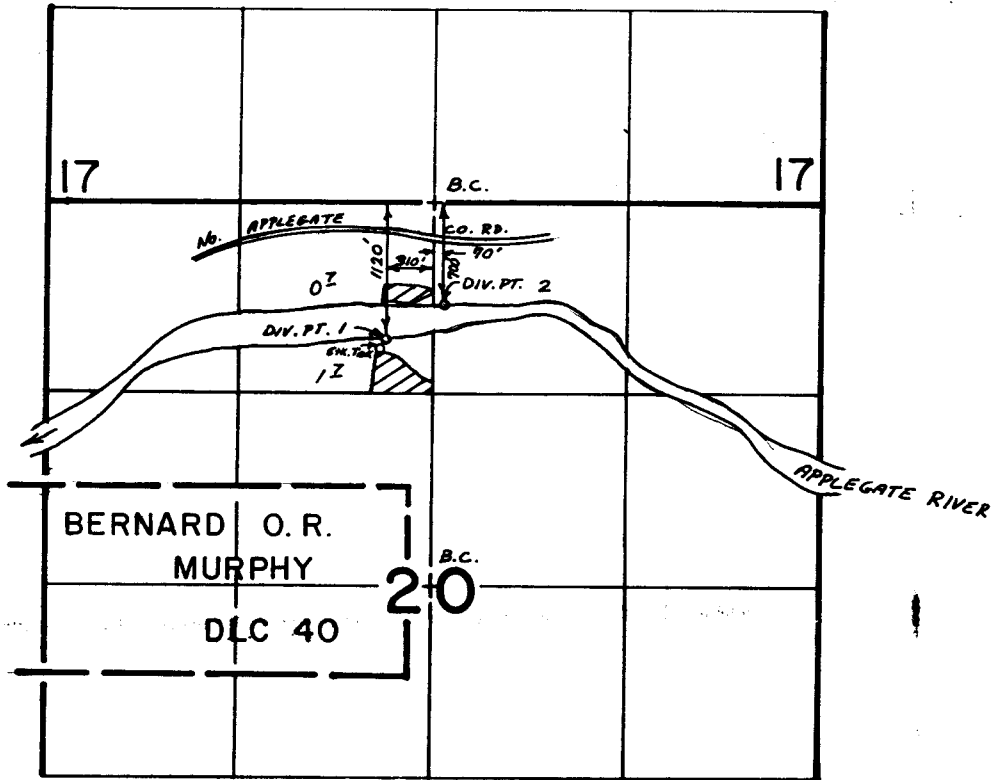

Scale: 4" = 1 Mile

**FINAL PROOF SURVEY**  
UNDER

Application No. 58857 Permit No. 44761.....  
IN NAME OF

WESLEY D. PARKER.....

Surveyed March 29 1982, by Bruce R. Sund

RECEIVED  
AUG 31 1990  
WIL. DIST. 14  
GRANTS PASS, ORE.

B50-1-3

bsj