


T. 40 S., R. 8 W., W.M.

RECEIVED

MAR 27 1986

WM. DIST. 14
GRANTS PLS. ORE

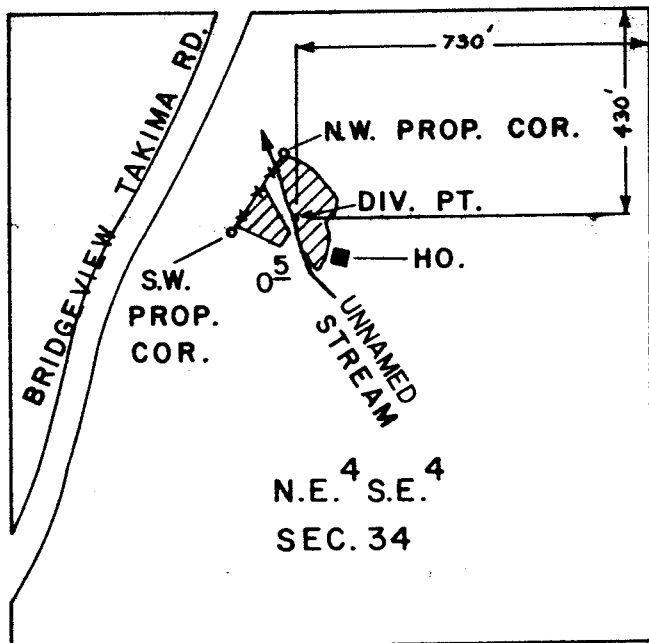

SCALE: 1" = 400 FT.

FINAL PROOF SURVEY
UNDER

60065

44786

Application No. Permit No.
IN NAME OF

..... ELLEN H. SANDERS

Surveyed JUN. 13 1979, by B. SUND
AUG. 26 1982 BRUCE R. SUND

D.H.M.

P.T.S. - 1979-14-B

T.W.B.

PTS-1982-14-A