


Application No. 7127
 Permit No. 4480

W

OFFICE OF STATE ENGINEER
 RECEIVED
 MAR 8 1920
 SALEM, OREGON

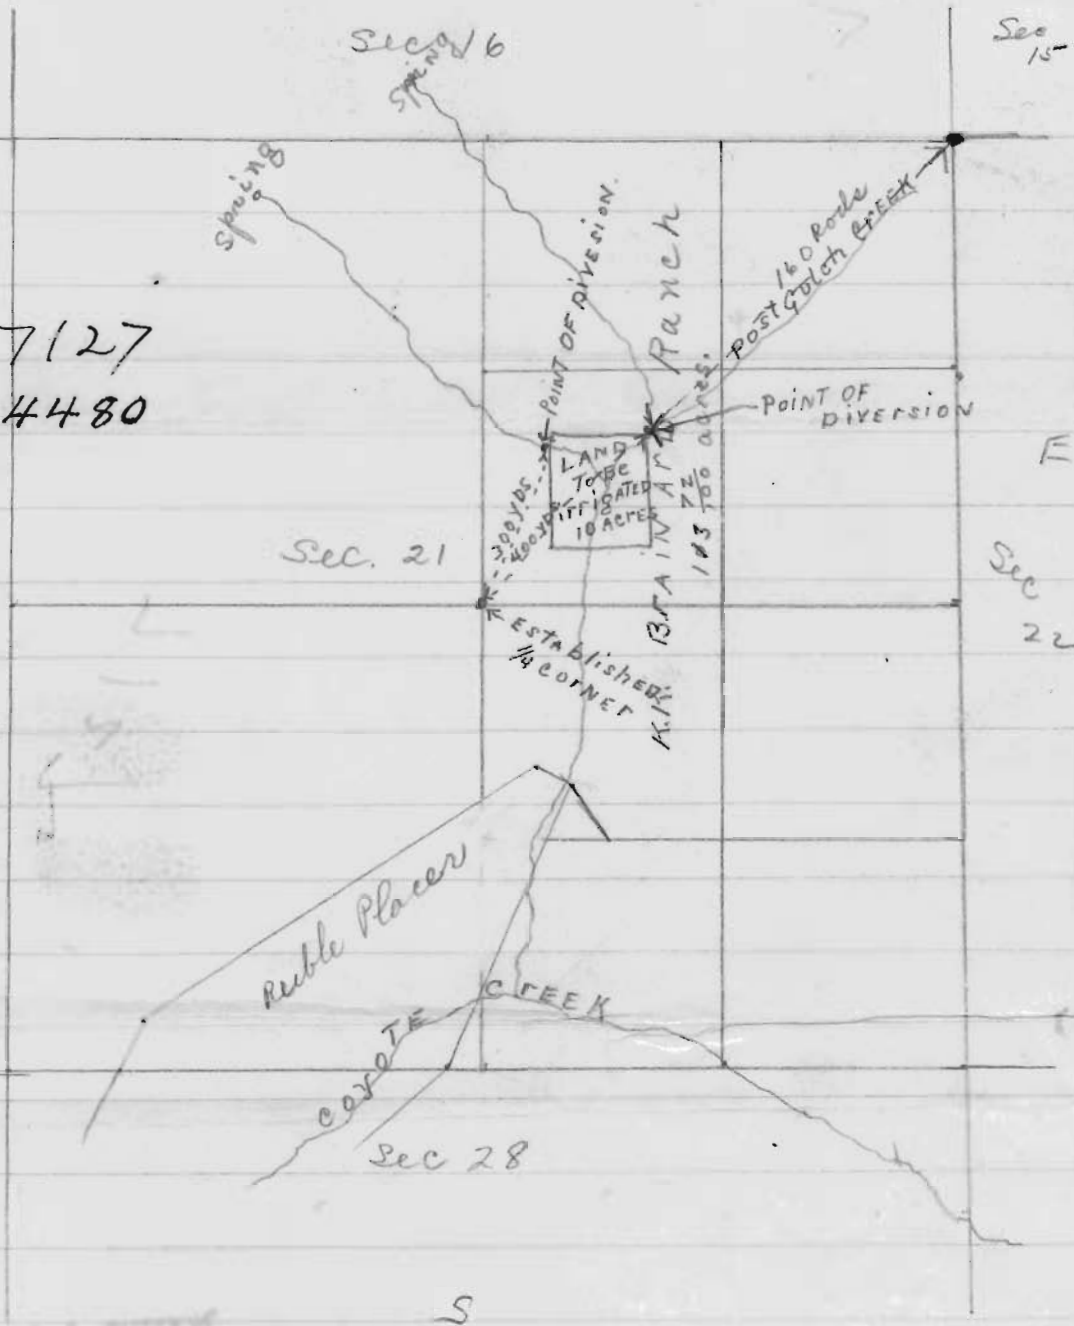

Map of 10 acres on K.K. Brainard Ranch for irrigation in Sec. 21 - T 33. R. S. 5 N. W. M. Source from Post gulch creek & two small springs.