


Permit: S 44915
Volume: 5
Strm: JUMPOFF JOE CR
Trib: ROGUE R
Priority: 7/20/79



T. 34 S., R. 5 & 6 W., W. VI.

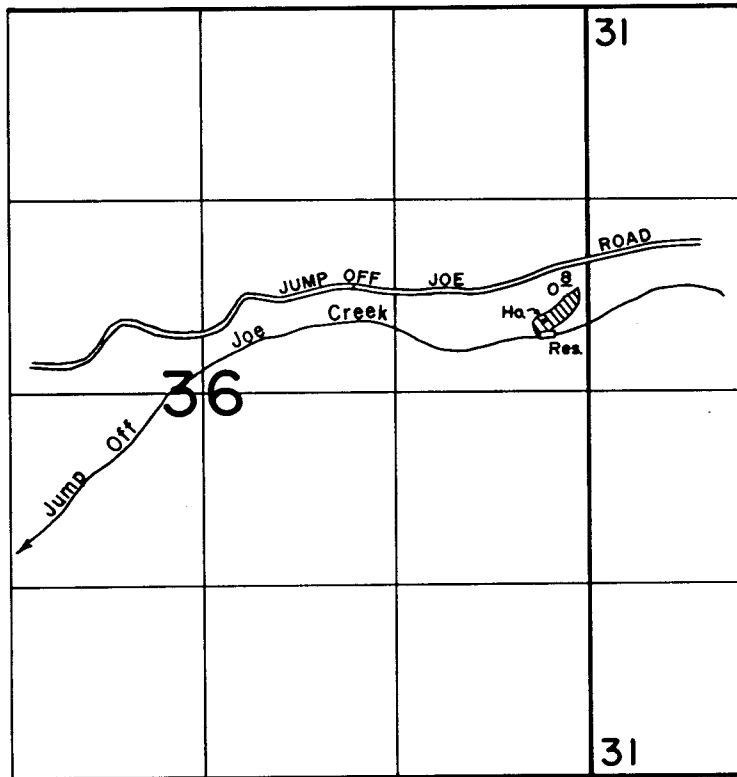

DAM LOC.: 370' N & 330' W. FROM E. 1/4 CORNER SECTION 36

SCALE: 1" = 1320'

FINAL PROOF SURVEY UNDER

R-58938 R-8143

Application No. ~~58939~~ Permit No. 44915.....
IN NAME OF

.....GRANT R. JONES.....

Surveyed MAY 15..... 1989, by B.S. JAMES.....

RECEIVED

JAN 08 1993

WM. DIST. 14
GRANTS PASS, ORG.

1-3-90
41033-179-133 L *gj*