


T.37S., R.7W., W.M.

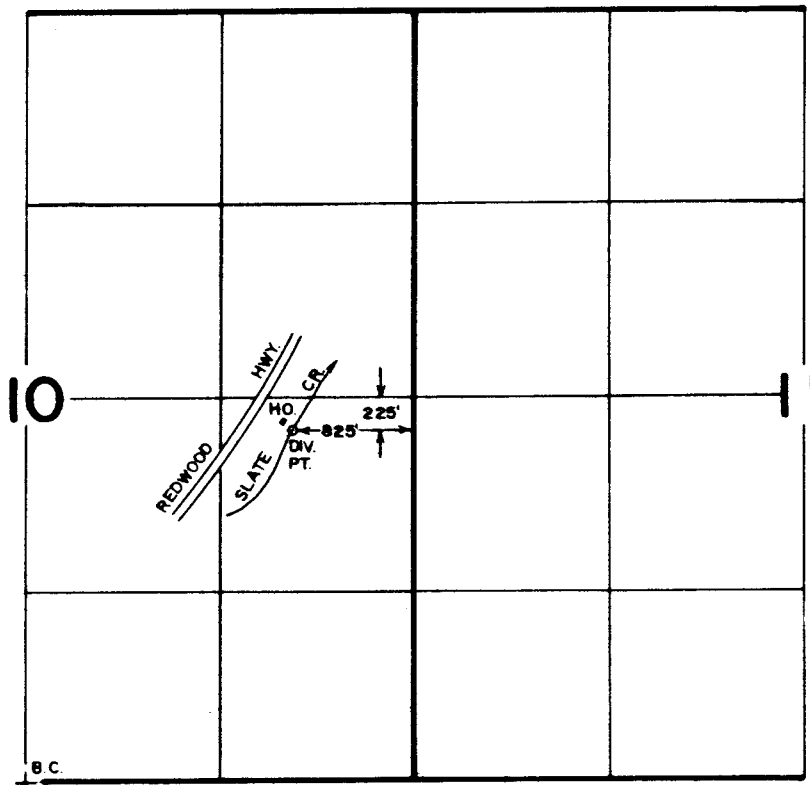

FINAL PROOF SURVEY
UNDER

FEB 27 1989

Application No. 59953 Permit No. 44940
IN NAME OF

PAUL E. WITHEM

Surveyed OCT. 24 1983, by B. S. JAMES

SCALE: 4" = 1 MILE

179-170L

TWB