


Application No. 60182
Permit No. 44961

RECEIVED

T.7S. R.1E. W.M.

MAY 27 1980
WATER RESOURCES DEPT.
SALEM, OREGON

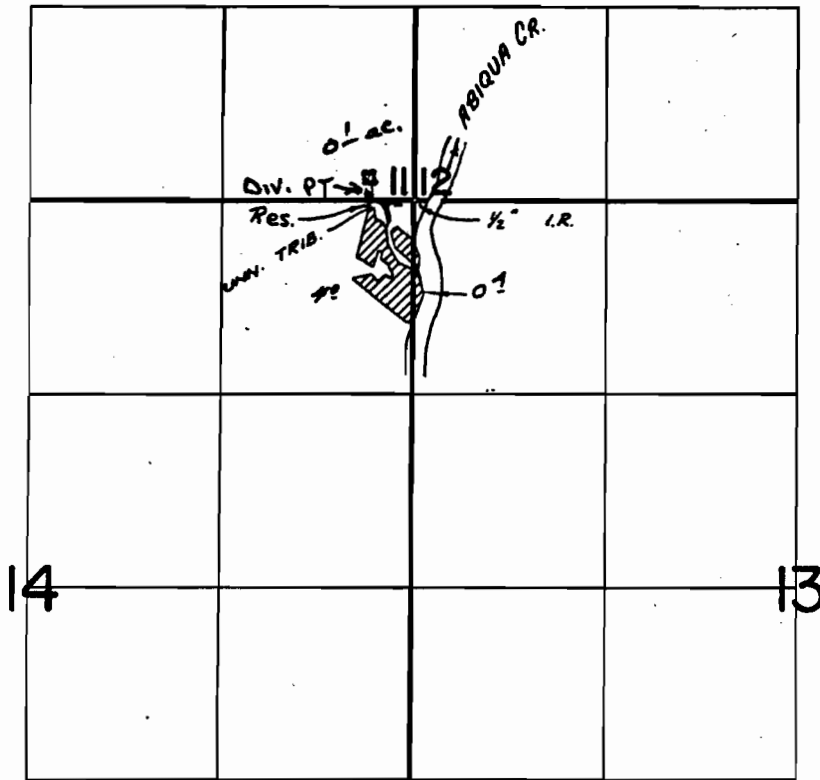

Div Pt. Res. Loc. 40' x 170' From NE Cor. Sec. 14
20' N. 300' W

THIS MAP PREPARED BY: Don Buell
FROM INFORMATION FURNISHED BY
THE APPLICANT.

~~FINAL PROOF SURVEY~~
UNDER

Application No. ~~R-40500~~ 40504 Permit No. ~~R-43552~~ 30252
IN NAME OF

~~ELBERT MANOR~~

Surveyed July 5, 1973, by R.G. Mucken