


T.39S., R.7W., W.M.

SEC. 19

RECEIVED

MAY 23 1985

W.M. DIST. 14
GRANTS PASS, ORE.

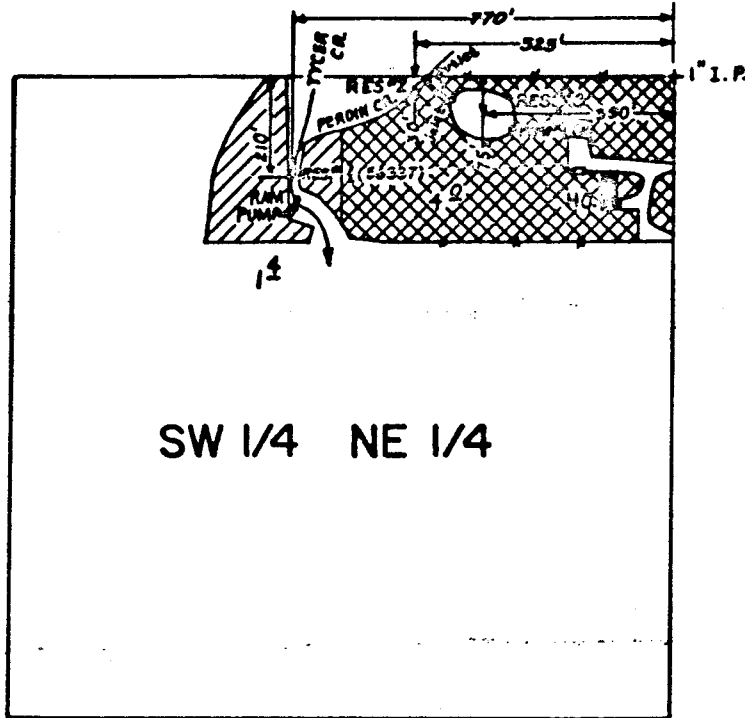

SW 1/4 NE 1/4

SCALE: 1" = 400'

- PRIMARY IRRIGATION from TYCER CREEK.
- SUPPLEMENTAL IRRIGATION from PERDIN CR. & STORED WATER.

FINAL PROOF SURVEY
UNDER

R-58996	R-8161
58997	44977
Application No. 56337	Permit No. 42366

IN NAME OF

.....RAYMOND JONES.....

Surveyed AUG. 25, 1982, by BRUCE R. SUND.

PTS-1982-14A

tbl