T. 39 S., R. 8 W., W. M.

JUL 19 1989

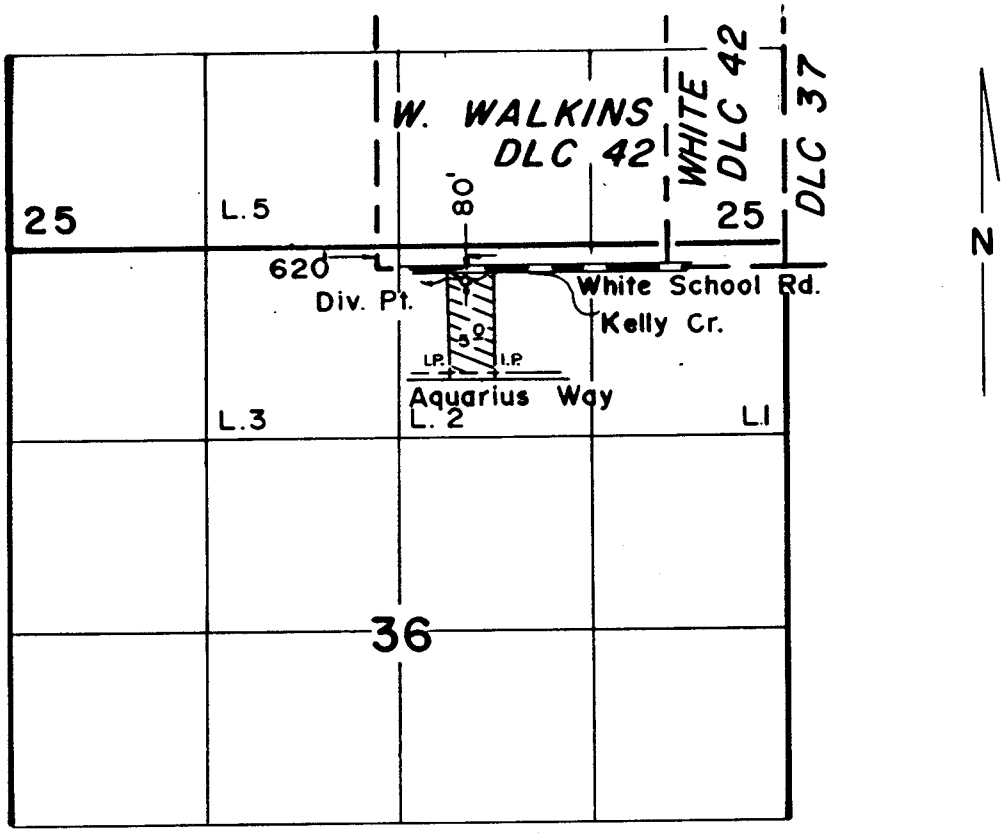

Scale: 1"=1320'

FINAL PROOF SURVEY
UNDER

Application No. 59729 Permit No. 44983
IN NAME OF

EVERETT W. CARLTON

Surveyed MAY 13 1986, by B. S. JAMES

41033-179-190L