


T.37S., R.4&5W., W.M.

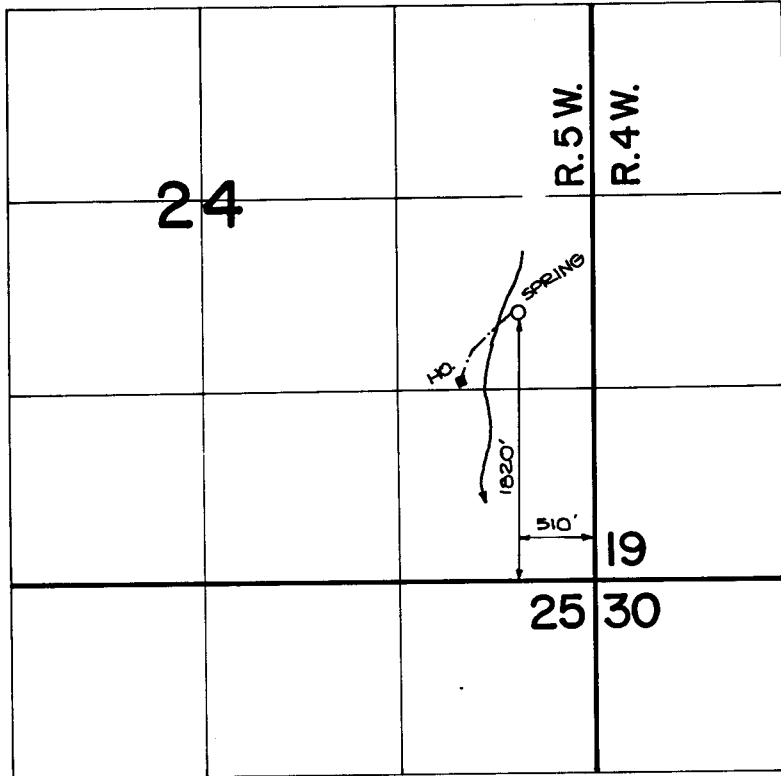

RECEIVED

APR 15 1987

WM. DIST. 14
GRANT'S PASS, ONE

FINAL PROOF SURVEY
UNDER

Application No. 60051 Permit No. 45064...
IN NAME OF

.....**SUSAN LIEBES**.....

Surveyed **MAY 14**, 19**82**, by **B. SUND**.....