


RECEIVED

NOV - 7 1979

WATER RESOURCES DEPT  
SALEM, OREGON

Application No. 59489  
Permit No. 45089

# TOWNSHIP 11 SOUTH, RANGE 7 WEST, W.M.

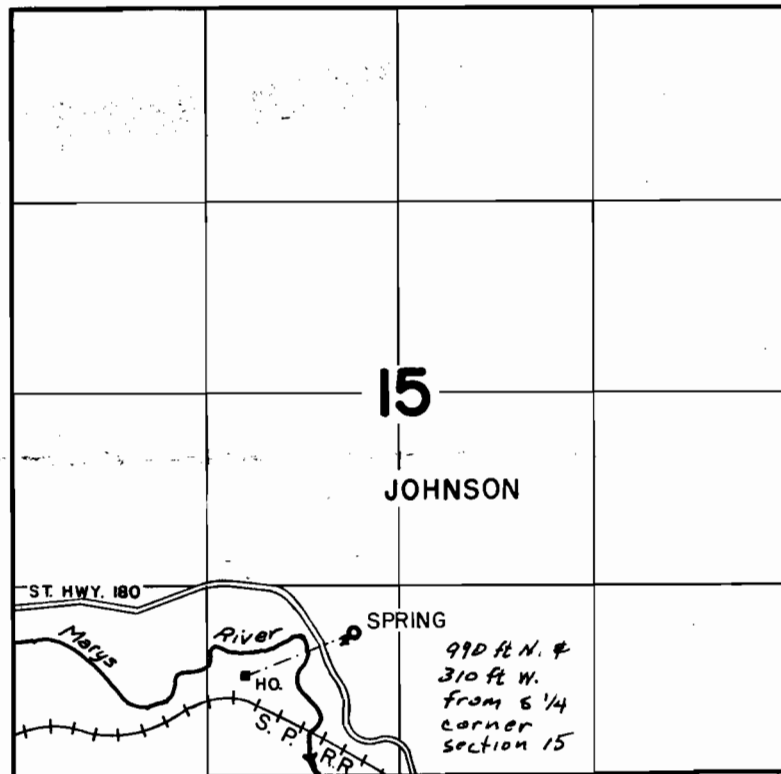

4" = 1 mile