


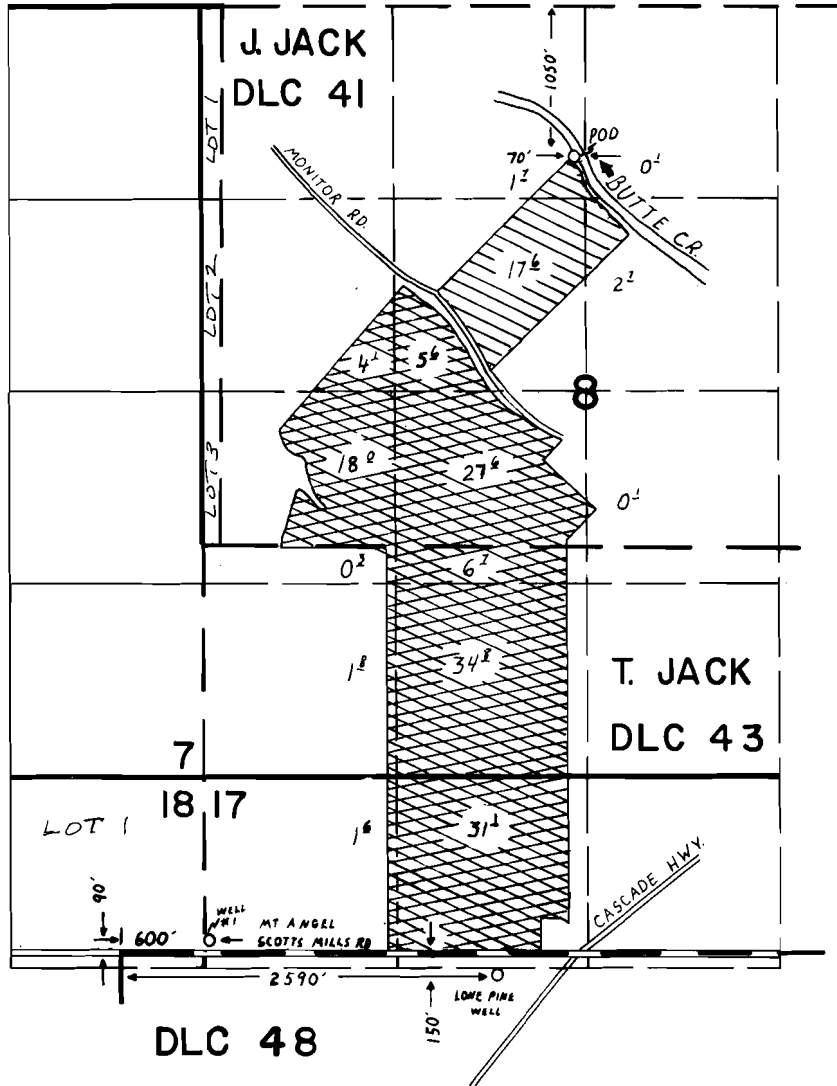

# T6S, R1E, WM



## FINAL PROOF SURVEY UNDER

-  APP 60133
-  APP G-9731

G-9731                      G-8954  
 Application No. ~~60133~~ Permit No. ~~45090~~  
 IN NAME OF

HAROLD KRAEMER

Surveyed MAY 18 1984, by B. W. BISHOP...