


T. 33 S., R. 18 E., W. M.

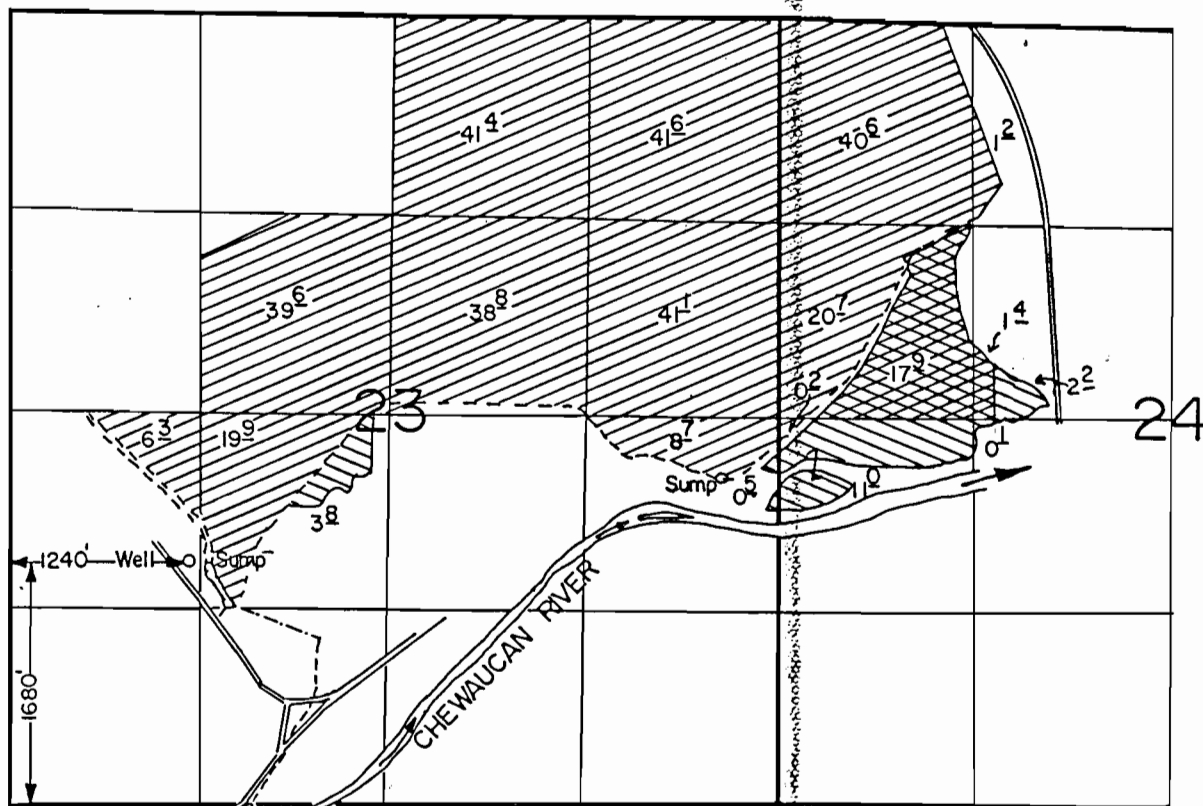

Scale: 1" = 1320'

FINAL PROOF SURVEY
UNDER

Transfer 4976

60308

45125

Application No. G-10683 Permit No. G-9765

IN NAME OF

ROSS H. & DORIS COLAHAN

Surveyed Oct. 15, 1985, by T. Warren