


# T. 37 S., R. 6 W., W.M.

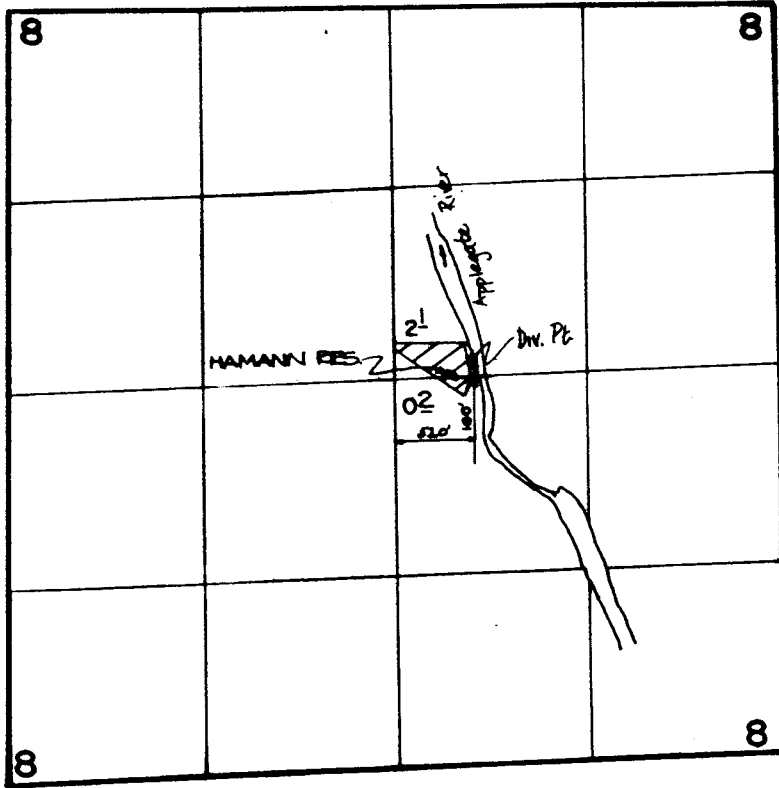

RECEIVED

AUG 23 1989

W.M. DIST. 14  
GRANTS PASS, ORE.

## FINAL PROOF SURVEY UNDER

62198                      46076  
Application No. 60234 Permit No. 45130.....  
IN NAME OF

**DALE B. & EURETHA M. HAMANN**

Surveyed OCT. 17, 1983, by B.S. JAMES.....

B50-2-9 mc