


T. 39 S., R. 8 W., W. M.

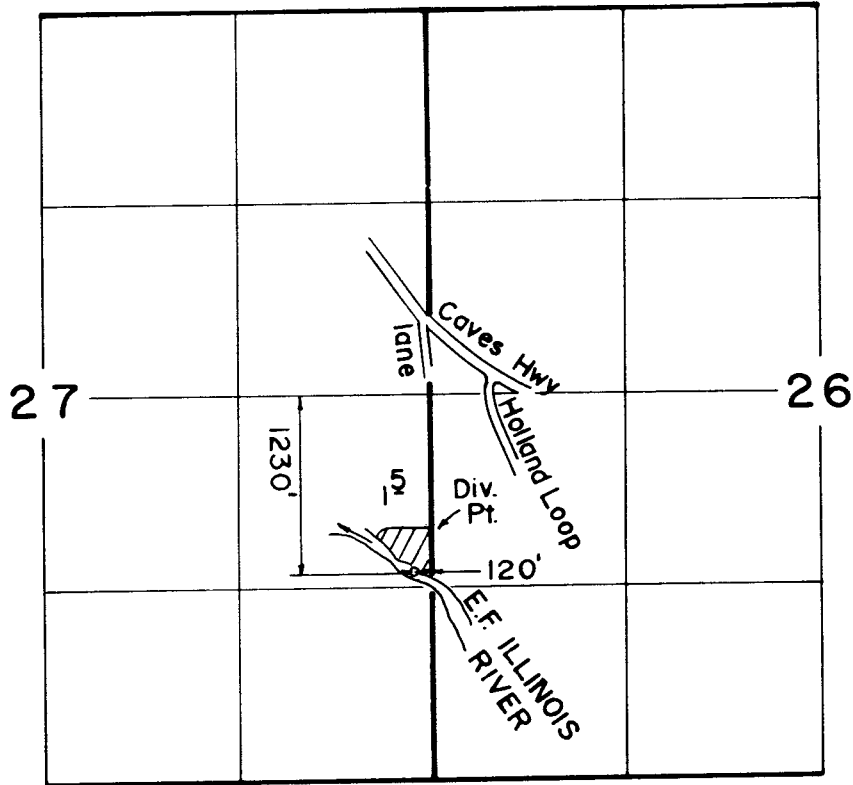

Scale: 1" = 1320'

RECEIVED

AUG 24 1989


FINAL PROOF SURVEY
UNDER

Application No. **60344** Permit No. **45135**
IN NAME OF

EDWARD HAFFER

Surveyed JUN...10.. 1986, by B.....S.....JAMES.