


T. 40 S., R. 8 W., W. M.

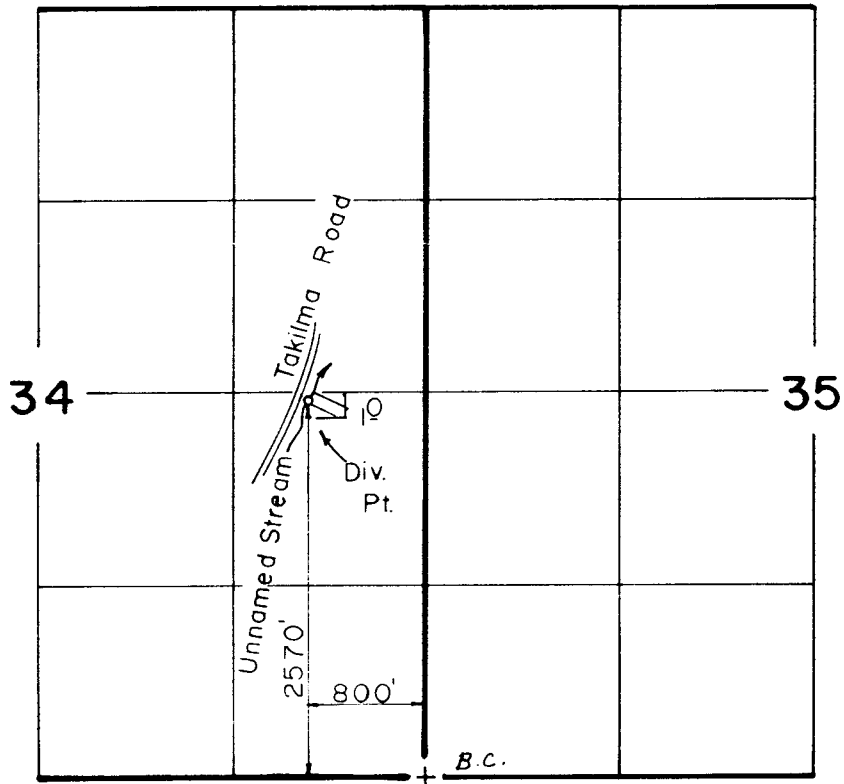

Scale: 1" = 1320'

FINAL PROOF SURVEY
UNDER

Application No. 60415 Permit No. 45138..
IN NAME OF

.....HAZEL W. ANDERS.....

Surveyed APR. 15. 19.86, by B. S. JAMES....

AUG 27 1989

41033-179-1876