


RECEIVED  
JUL 28 1980  
WATER RESOURCES DEPT  
SALEM, OREGON

T29S R12W

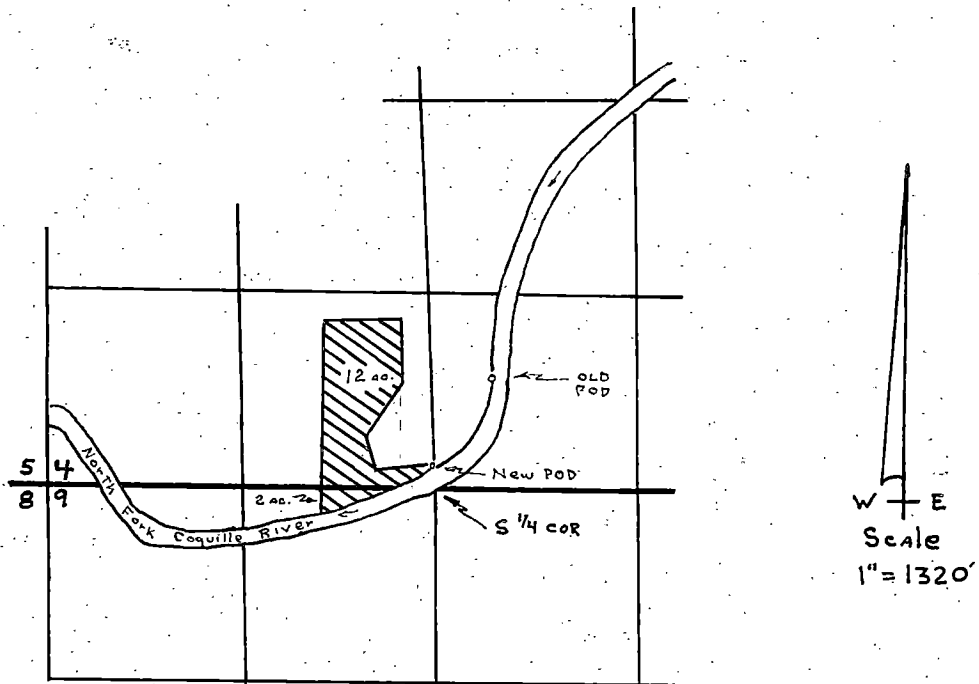

Application No. 60422  
Permit No. 45174