


T.35S.,R.7W.,W.M.

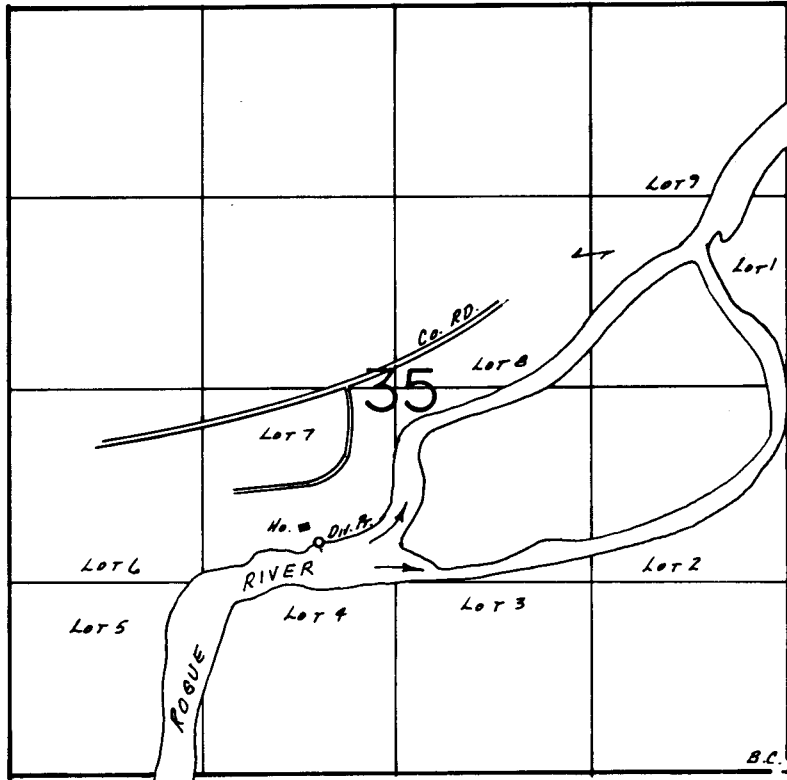

Div. Pt. Loc.: 1050'S. 1/4 S10W. FROM CENTER SECTION 35.

SCALE: 1"=1320'

FINAL PROOF SURVEY
UNDER

Application No. 60338.. Permit No. 45306.....
IN NAME OF

KARL M. & BEATRICE J. BENNETT

Surveyed Oct. 23... 19.85, by B.S. JAMES.....

RECEIVED

AUG 3 1987

WM DIST. 14
GRANTS PAGE ONE

4/24/86
41033-179-166R BJB