


T. 40 S., R. 9 W., W. M.

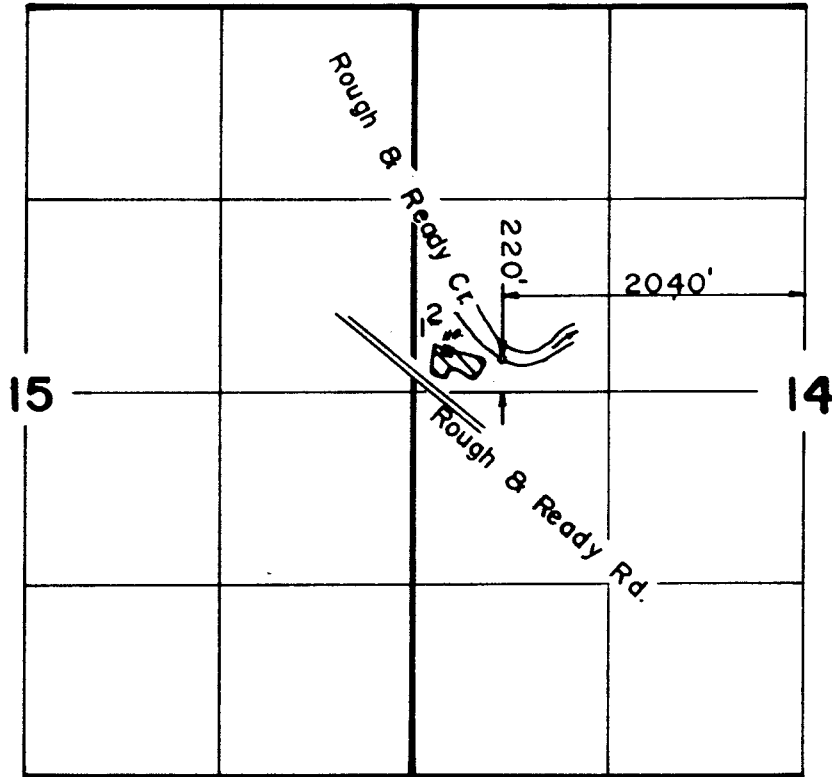

Scale: 1" = 1320'

RECORDED
FEB 27 1989

FINAL PROOF SURVEY
UNDER

Application No. 60267 Permit No. 45308
IN NAME OF

CARRON ADAMS

Surveyed APR. 10. 1986., by B. S. JAMES

41033-179-245R 144