


T. 28 S., R. 5 W., W. M.

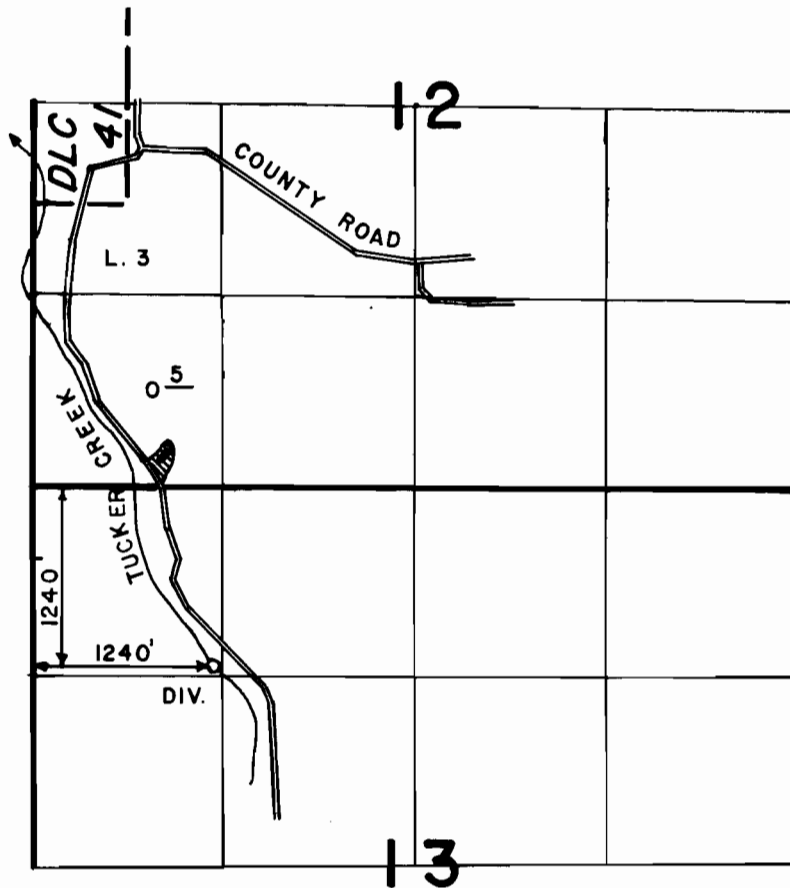

SCALE: 4" = 1 MILE

**FINAL PROOF SURVEY**  
UNDER

Application No. 60629 Permit No. 45391.....  
IN NAME OF

**CLARAN H. JESSE AND MARJORIE D. JESSE**

Surveyed JAN. 8..... 1988, by J. M. SCHMORDE