


TOWNSHIP 95, RANGE 1W, W. M.

North

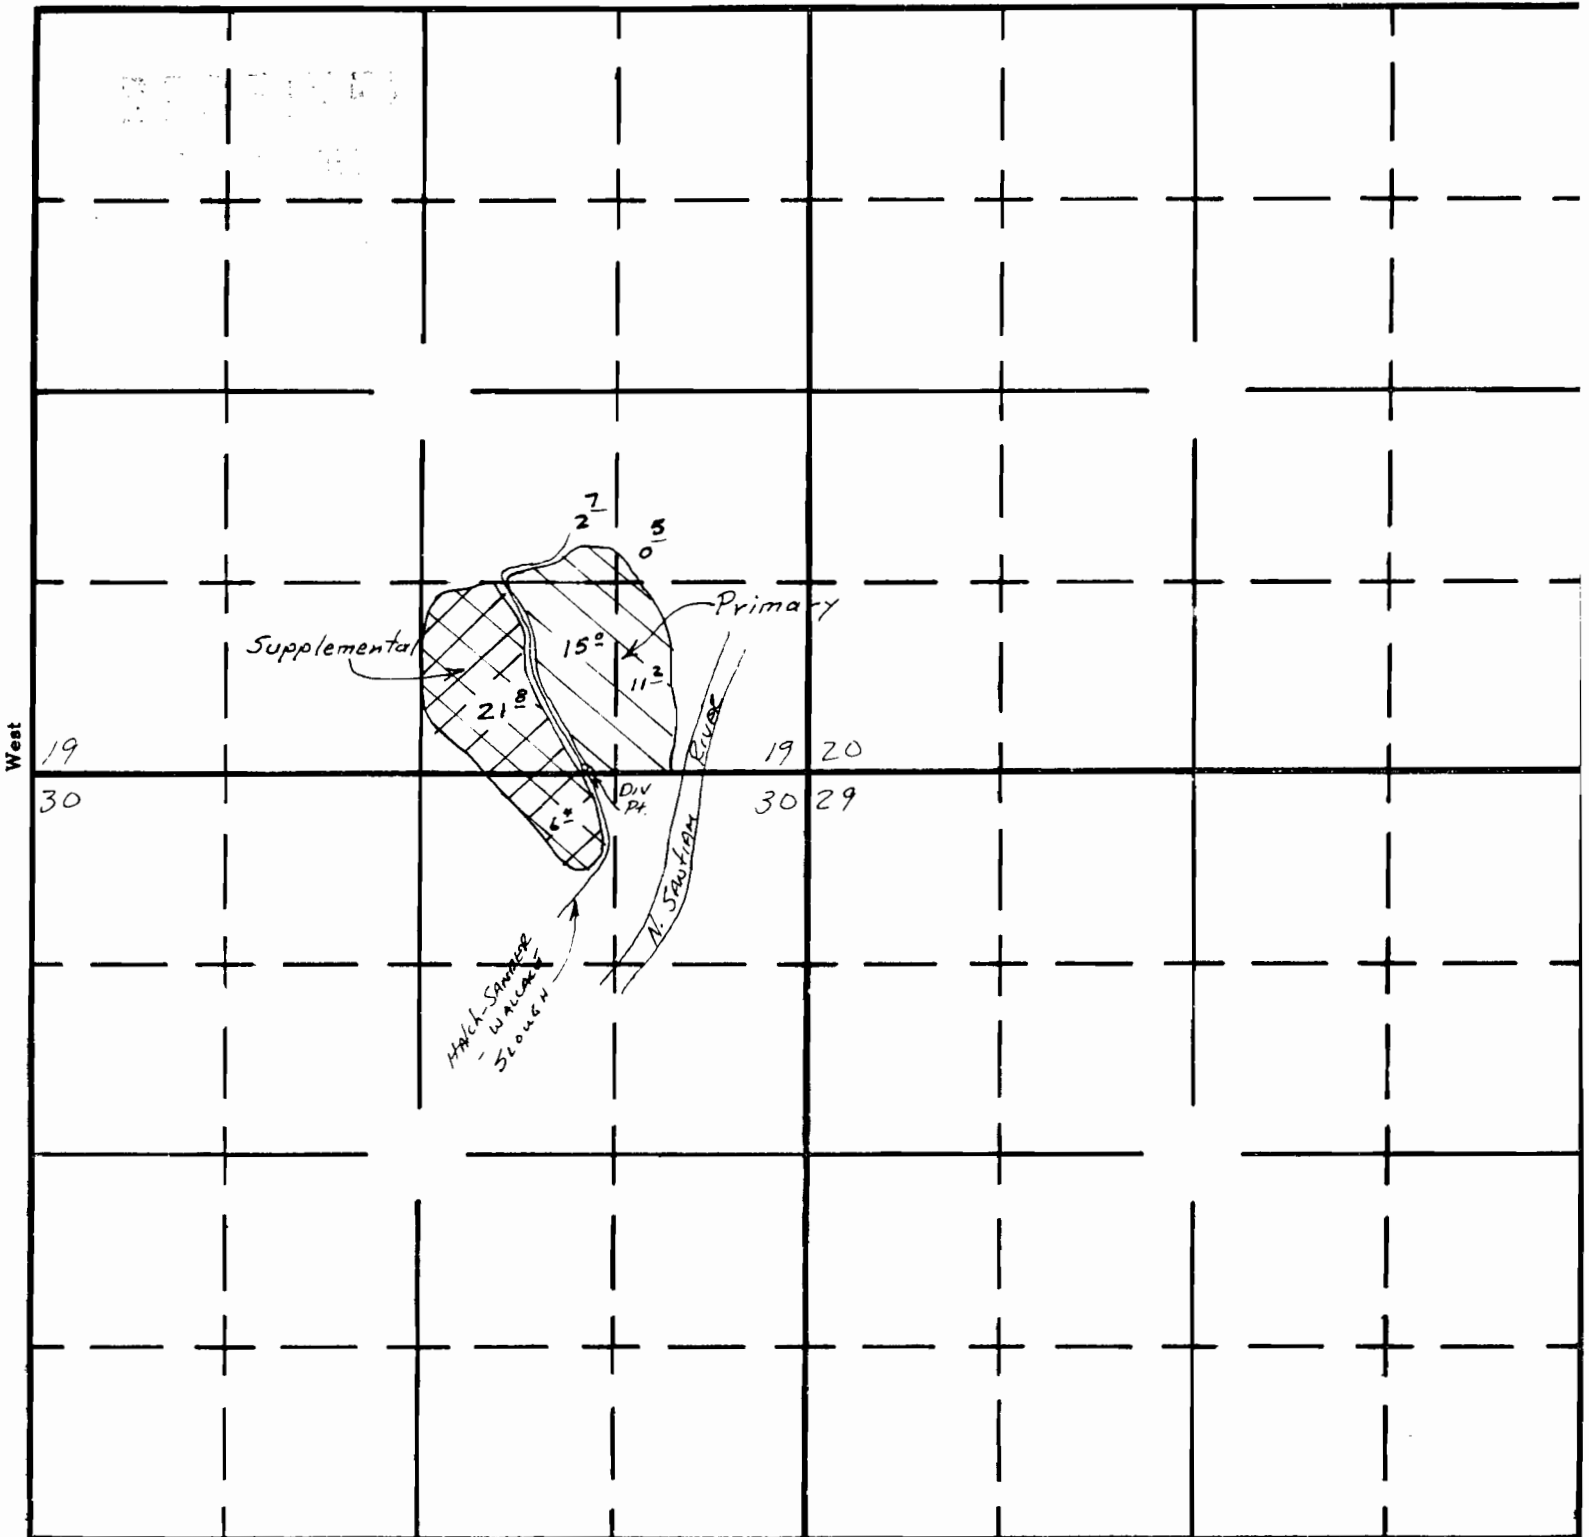

South

Div. Point Loc: SW¹/₄ SE¹/₄ Section 19
3750 feet EAST AND 50 feet
North from the SW Corner Section 19

APPLICATION No.
PERMIT No.

51906
45426