


RECORDED

SEP 8 1980

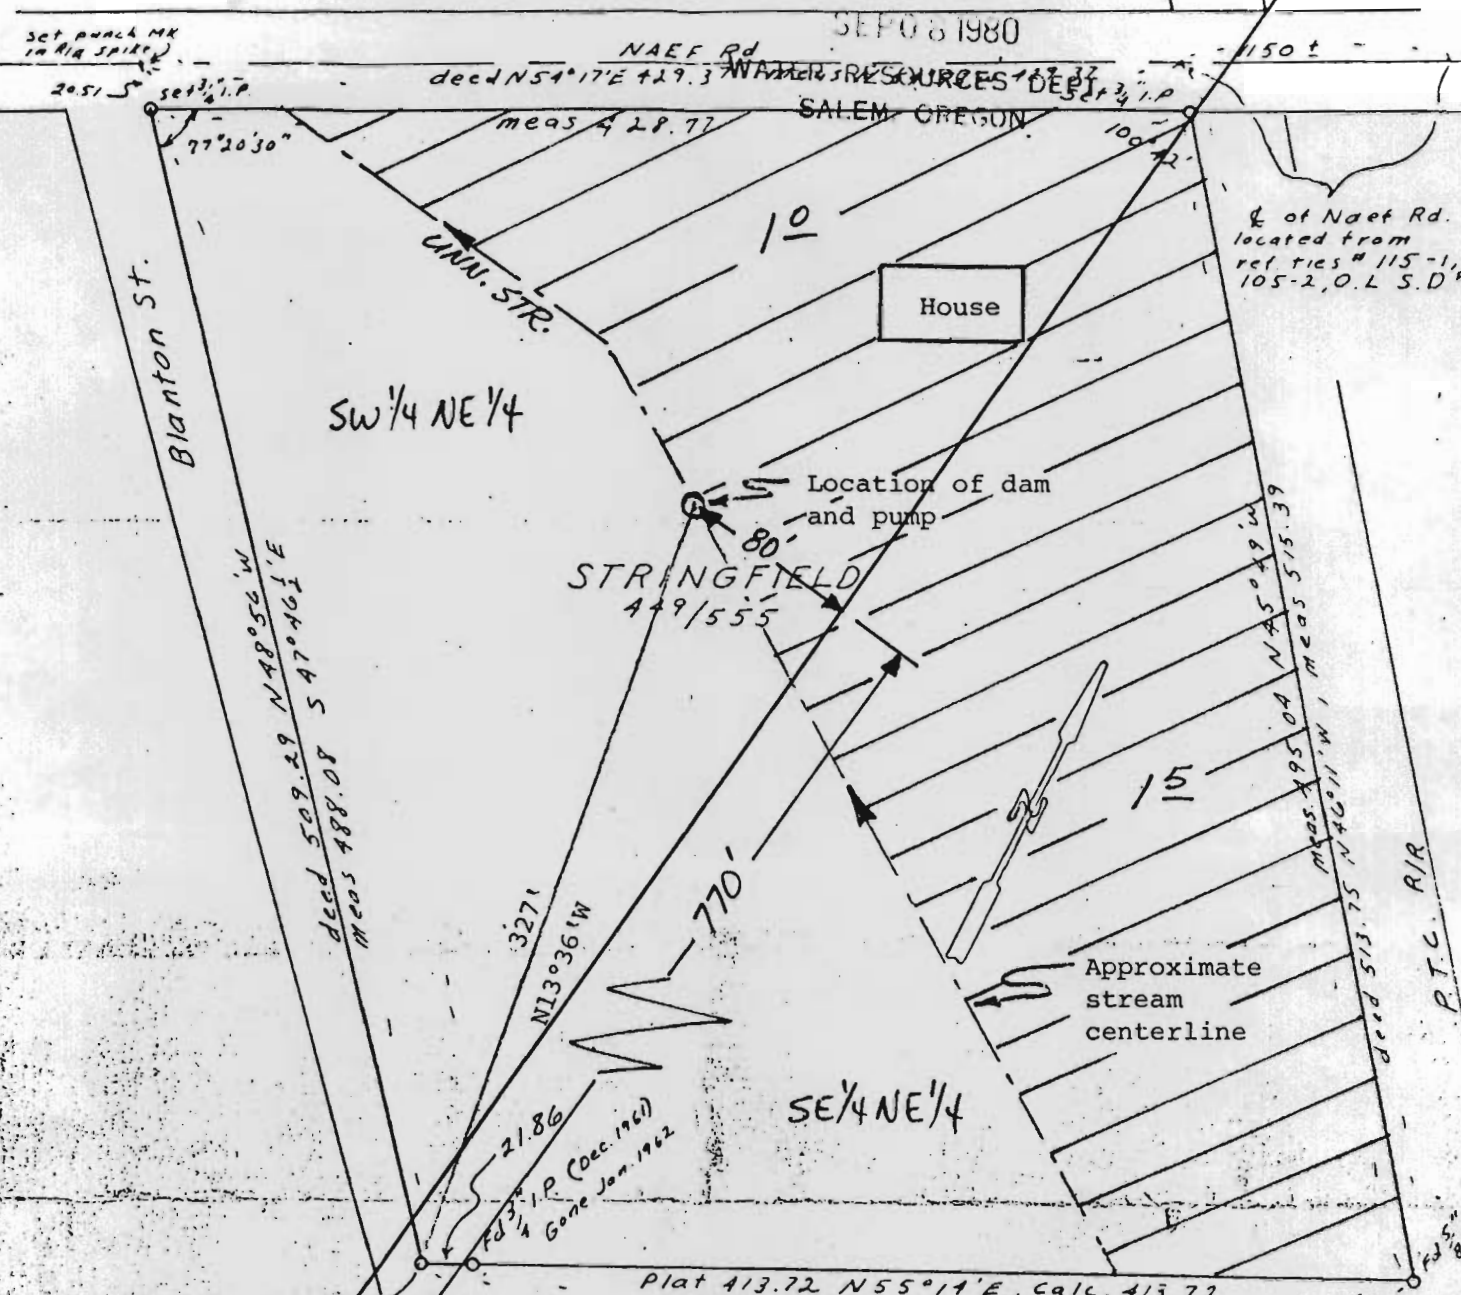

Bearings based on I.R. & I.P. Fd in the N. Line of the plat of "Covell".
 This deed fails to Close mathematically.
 N & S. Lines set at deed distance.

T 25 R 1 E Sec 13
 Scale 1" = 80'

REGISTERED
 LAND SURVEYOR

Bertell Mason, Jr.
 BERTELL MASON, JR.
 112

SE. cor
 SW 1/4 NE 1/4
 Sec 13

SURVEY IN
 B.B. ROGERS
 SEC 13 T 2 S. R. 1 E
 For Theodore Stringfield
 3614 S.E. Naef Rd.
 By Bert Mason, Jr., Oak Grove, Oregon
 December, 1961.
 SCALE 1" = 80'

Note: Base property survey only by Bertell Mason; stream and irrigation data (typed) by T. A. Stringfield

State of Oregon Water Resources Dept.
 Application No. _____
 Permit No. _____

Application No. 60591
 Permit No. 45430