


RECEIVED
JUL 7 1980
WATER RESOURCES DEPT
SALEM, OREGON

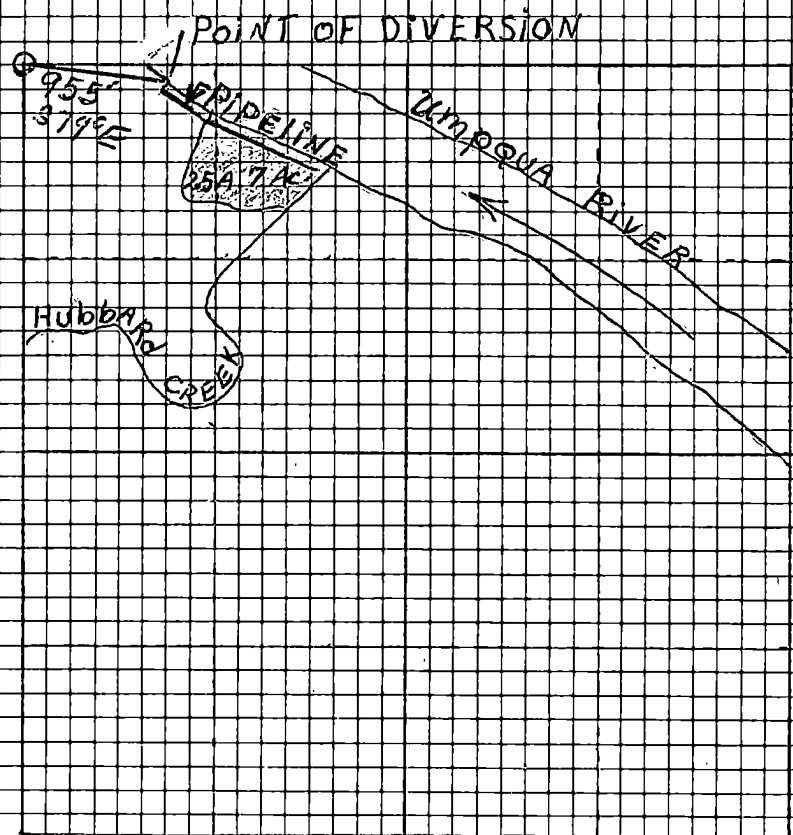

SECTION 21 T25 S. R 7 W.

NW $\frac{1}{4}$ NW $\frac{1}{4}$ 2.5 AC. NE $\frac{1}{4}$ NW $\frac{1}{4}$ 7 AC.

4" = 1 MILE

Application No. 60321

Permit No. 45541