


T. 29S. R. 4W. W.M.

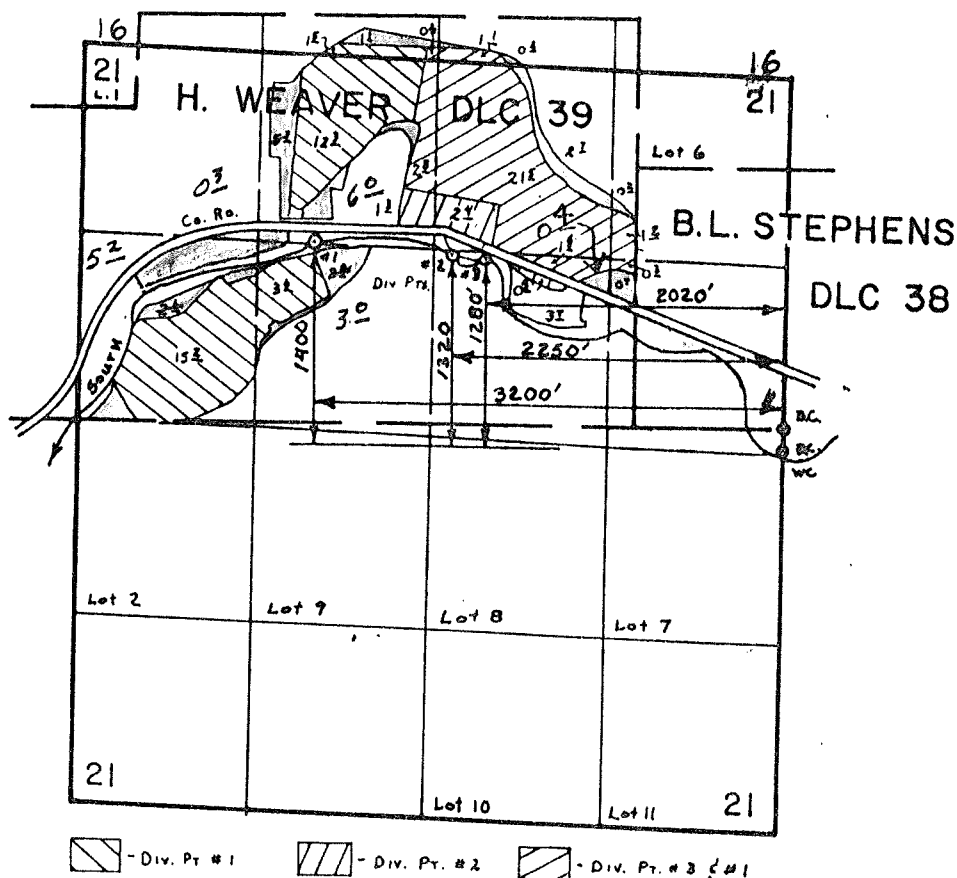

SCALE: 1" = 1320'

Application No. 61277
 Permit No. 45605

Transfer No. B-198

Application No. Permit No.

IN NAME OF

HOWARD BROWNSON

Surveyed April 20 1978, by D. Sparks

RECEIVED

FEB 25 1981

WATER RESOURCES DEPT
 SALEM, OREGON