


RECEIVED

FEB 12 1981

WATER RESOURCES DEPT
SALEM, OREGON



Application No. 61249
Permit No. 45616

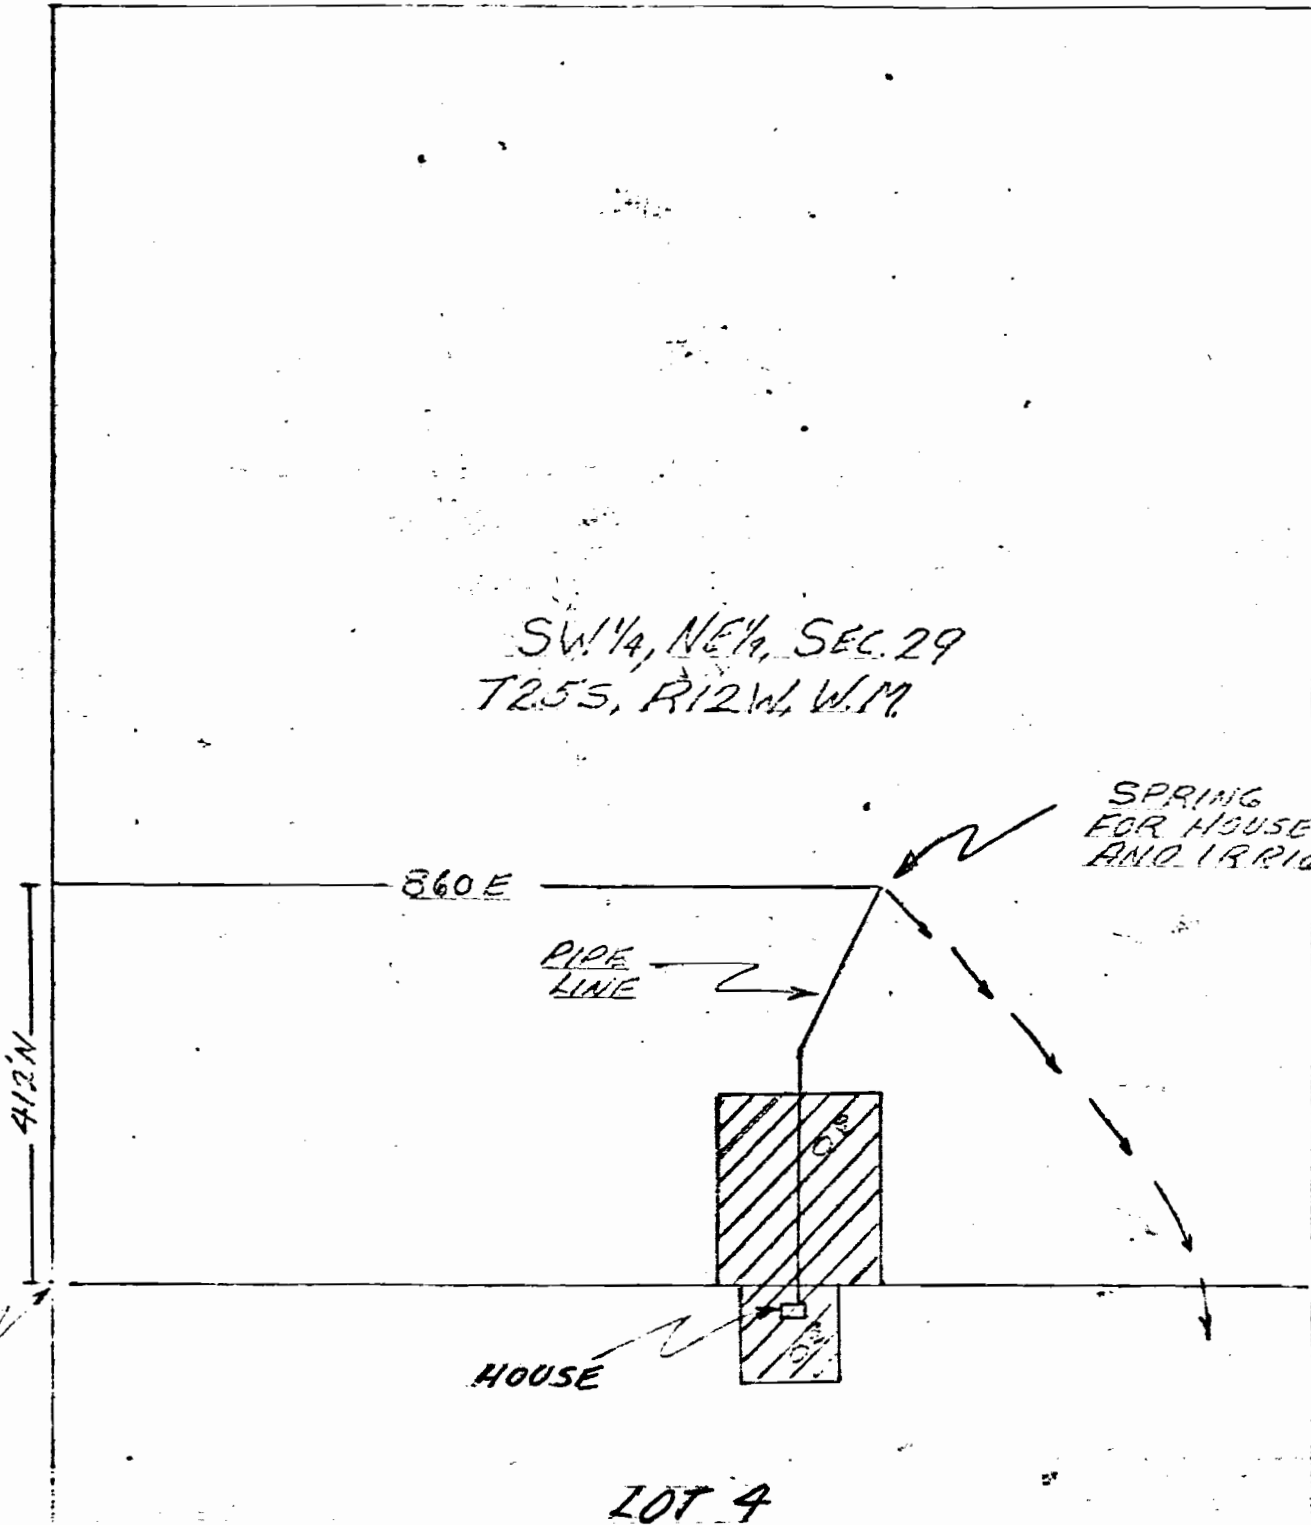

CENTER OF SEC. 29 IN
T25S, R12W, W.M.
MARKED BY OLD PIPE
& UNDER GROUND

Scale 1"=200'