


T. 33S., R. 6W, W.M.

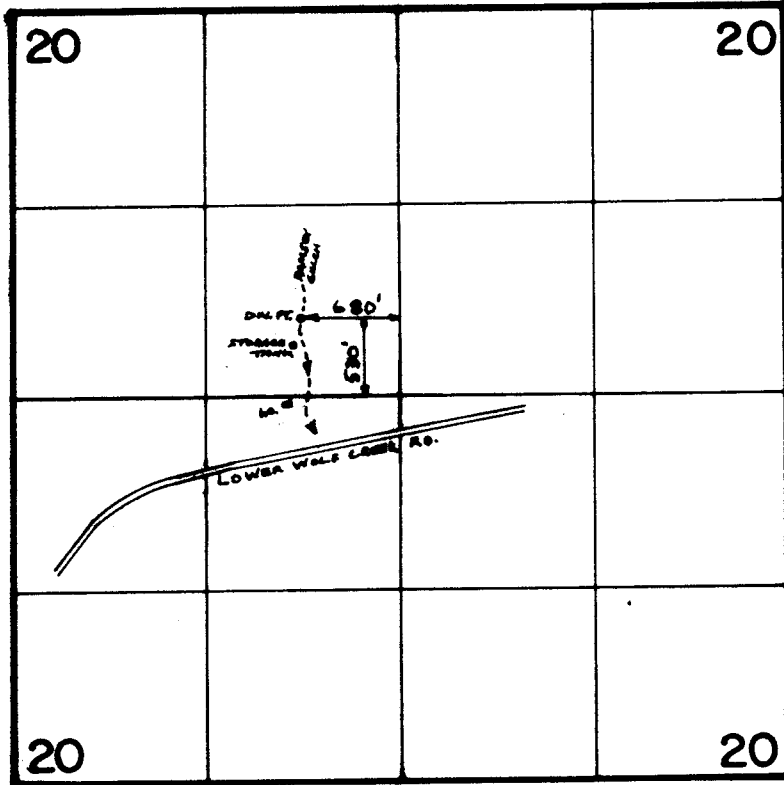

SCALE 1" = 1320"

RECEIVED

MAR 30 1988

PLANNING

FINAL PROOF SURVEY
UNDER

Application No. 61065..... Permit No. 45625.....
IN NAME OF

.....**GEORGE & MARION E. BOWEN**.....

Surveyed **SEPT. 5**... 19**84**.. by **J.R. WOODROOF**..

41033-179-155L

J.R.W.