
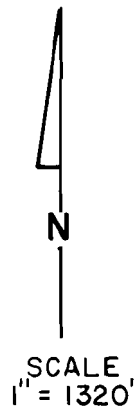


T. 2 S., R. 3 W. WM.

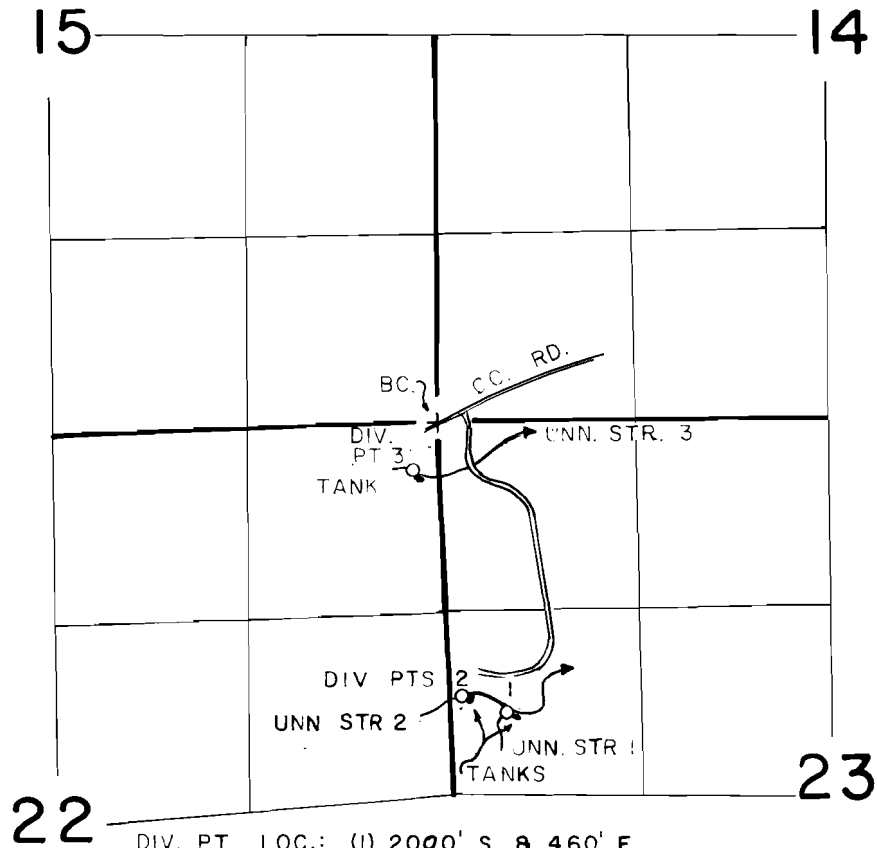

22 DIV. PT. LOC.: (1) 2000' S. & 460' E.
(2) 1870' S. & 160' E.
(3) 340' S. & 180' W.
FROM NW COR. SEC. 23

FINAL PROOF SURVEY
UNDER

Application No. 58949 45632
58950 Permit No. 45633
IN NAME OF

PAUL CASAVANT

Surveyed JUL 26 1984, by P. PAGTER