



T.37S., R.7W., W.M.

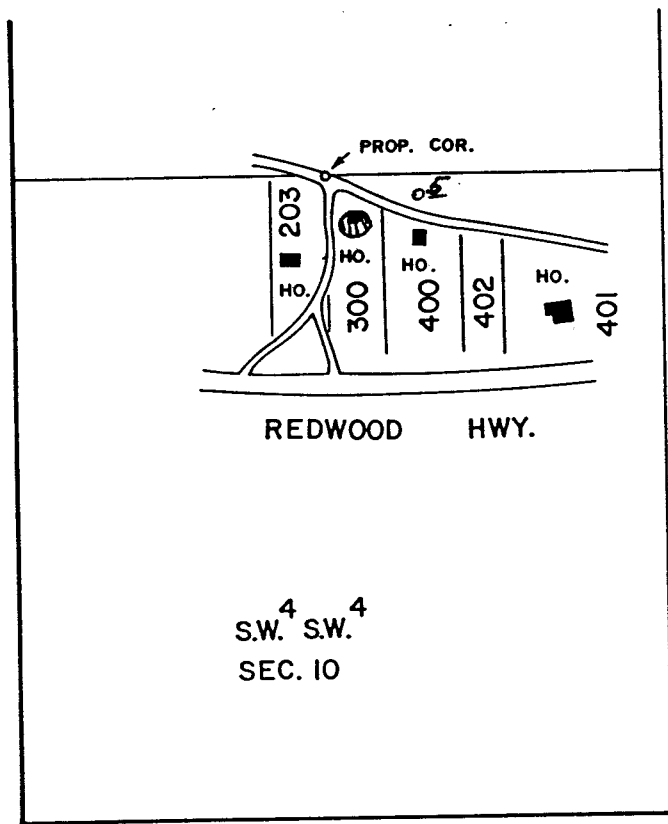

SCALE : 1" = 400 FT.

T.37S., R.7W., W.M.

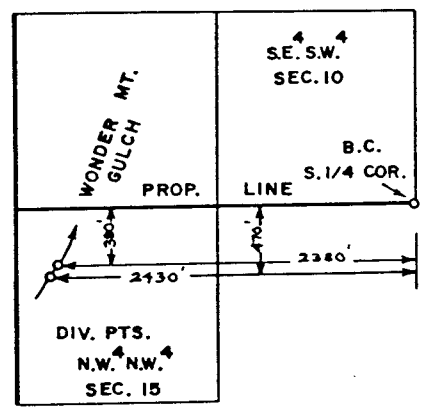

~~FINAL PROOF SURVEY~~ UNDER

TRANSFER NO. 4493
 APPLICATION NO. 60078
 PERMIT NO. 45655

ARTIE JAMES & LOIS ANN MARTIN
 LOT 300
 AUGUST 16, 1982; B.S. JAMES
 SURVEYED: APRIL 25, 1980; B.R. SUND.

D.H.M.
 P.T.S. -1980-14-A