


T. 36 S., R. 5 W., W.M.

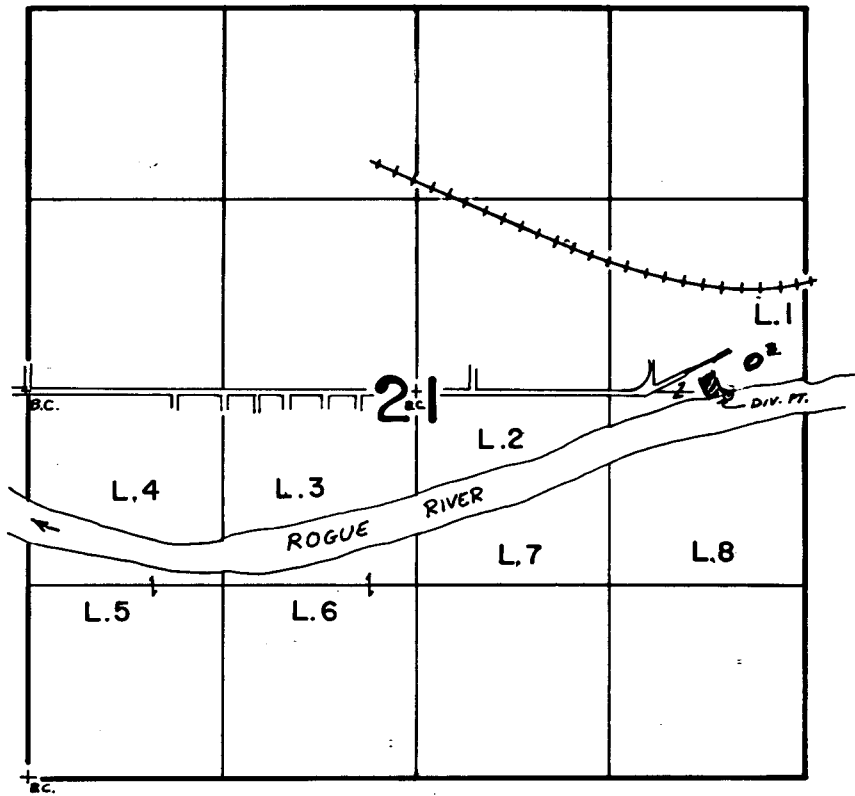

RECEIVED
SEP 1 1987
WM. DIST. 14
GRANTS PASSE. ORE.

DIV. PT. : 20'S & 2130'E FROM CENTER 1/4 COR. SECTION 21

Scale 4" = 1 mile

FINAL PROOF SURVEY
UNDER

Application No. 61358. Permit No. 45679...
IN NAME OF

.....**MYRON A. & JANE H. JOHNSON**.....

Surveyed Oct. 21, 1981, by Bruce R. Sund.