

Survey of tracts in U.S. Lot 29, Sec. 33, T 9 S, R 9 W,

July 7, 1967 For Mr P. Gregory Scale: 1" = 100'

I based my survey on pipes found as set by John H. H. in O.S. # 1920 using his bearings as a base and tied to an iron rod set for the N.E. corner of said Lot 29.


REGISTERED
OREGON
LAND SURVEYOR

W.H. Burdett
NOV. 18 1944
W. H. BURDETT
45

RECEIVED
APR 29 1981
WATER RESOURCES DEPT
SALEM, OREGON

Application No. 60299
Permit No. 45685

RECEIVED
JUN 26 1980
WATER RESOURCES DEPT.
SALEM, OREGON

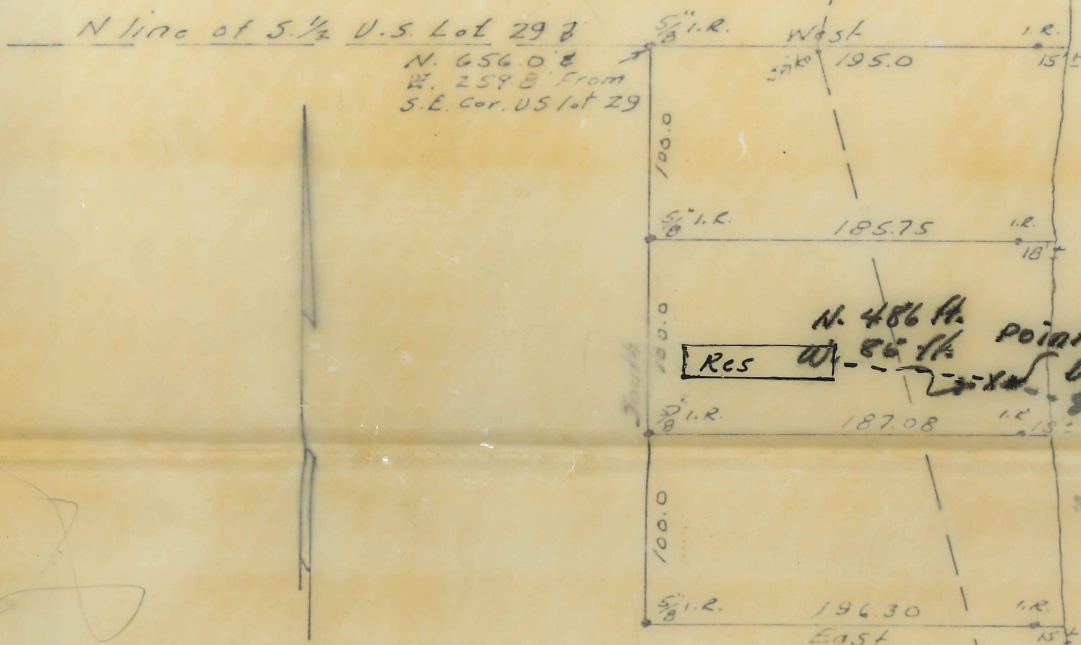

SE cor. Gov
Lot 29

West-660.0 to 1/4 Cor S line Sec. 33
Sec. 4

T 9 S, R 9 W
T 10 S, R 9 W