


T.2 N.R.4 W.W.M.

Scale 4" = 1 mile

RECEIVED

AUG 28 1980

WATER RESOURCES DEPT  
SALEM, OREGON

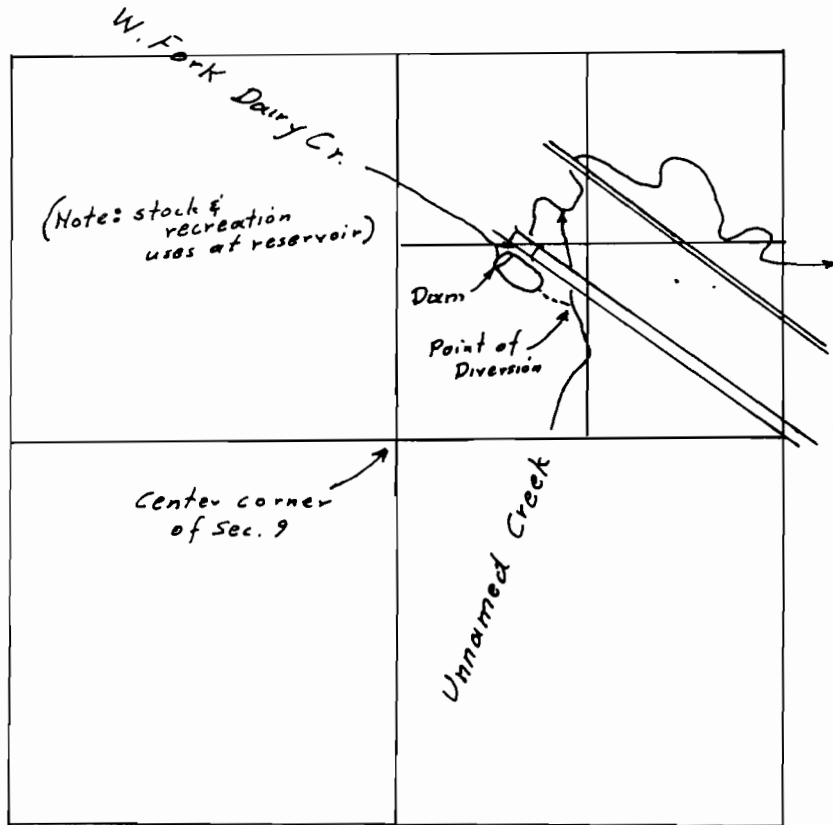

Dam located: 1250 ft. N. & 700 ft. E from  
the center corner of Sec. 9

Point of Diversion on Creek located:  
925 ft. N. & 1200 ft. E. from the  
center corner of Sec. 9

Application No. 60567  
Permit No. 45700

R-60566  
R 8237