

RECEIVED

MAY 19 1981

R 7 E R 8 E

WATER RESOURCES DEPT  
SALEM, OREGON

T 25 S


T 27 S



R 8 E

R 9

WATER RESOURCES DEPT  
SALEM, OREGON

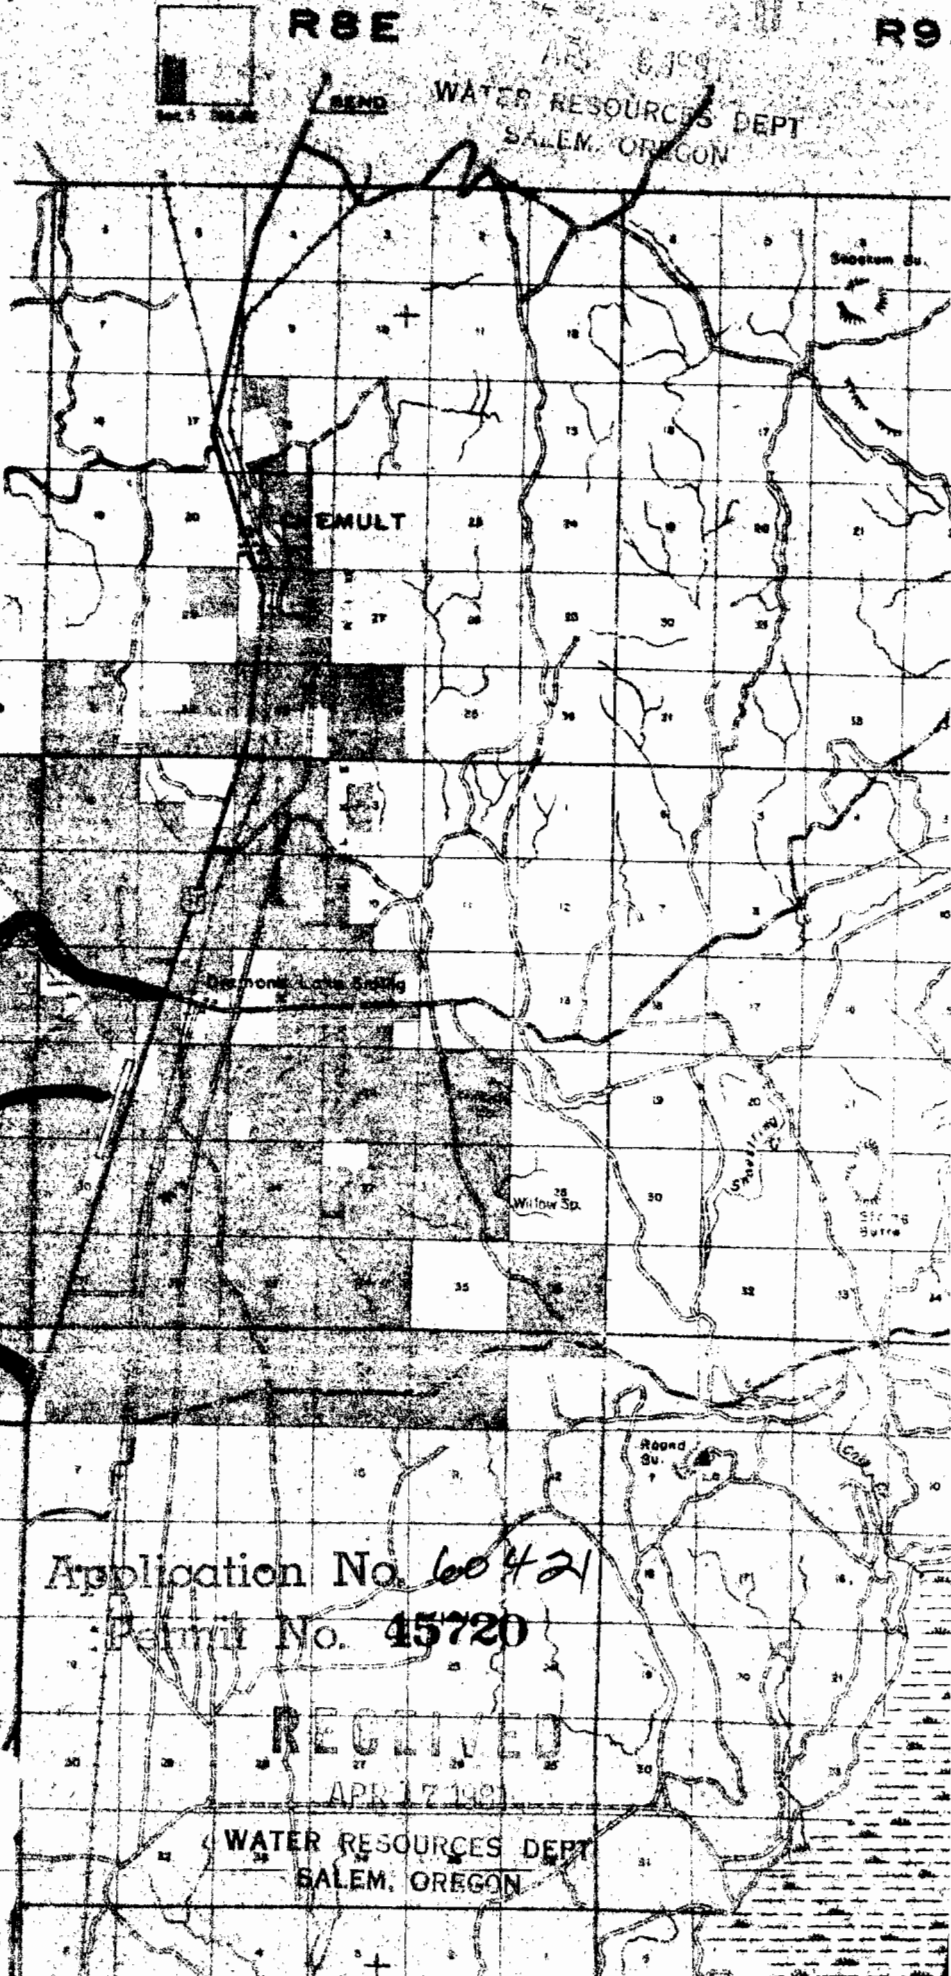

MULT


Willow Sp.

Diamond Lake  
Junction

Round  
Su.

Application No. 60421

Permit No. 45720

RECEIVED

APR 17 1981

WATER RESOURCES DEPT  
SALEM, OREGON


T 25 S R 7 E  
T 27 S R 7 E  
3 S R 7 E  
3 S R 7 E

RECEIVED  
JUL 29 1980  
WATER RESOURCES DEPT  
SALEM, OREGON

FILED  
APR 6 1981  
WATER RESOURCES DEPT  
SALEM, OREGON

Forked Horn Springs

water source

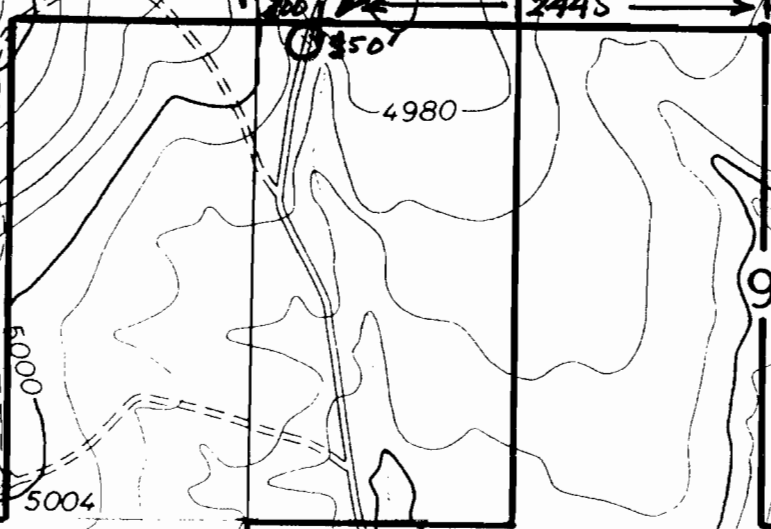

Application No. 64421  
Permit No. 45720

1" = 1000'  
N  
T28S R7E. W.M.

3

7

16

960

4796

4820

4980

4900

4900

4920

4871

4900

4820

5100

5100

5000

5000

5004