

Revised Application Map
for Application #59907

RECEIVED


MAY 5 1981

WATER RESOURCES DEPT
SALEM, OREGON

T.29S.R.14W.W.M.

Application No. 59907

Permit No. 45731

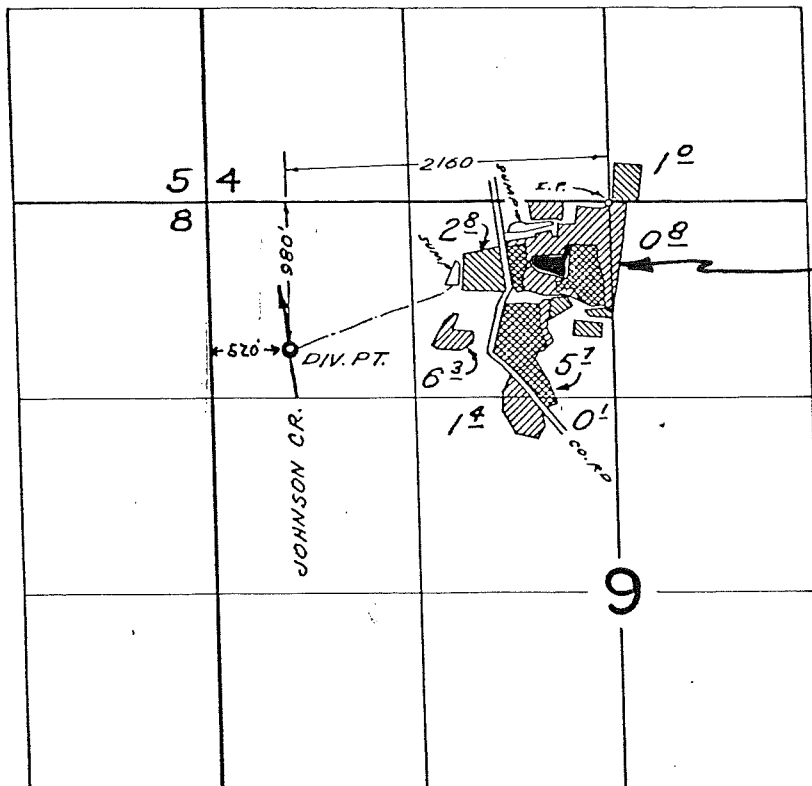

1 ac IN NE NW
BLACK
SHADED IN yellow:
Irrigation, Temp control,
AND flood harvest.
All other AREAS for
Temp control and flood
harvest. total
ac for flood harvest
and temp control only
18.1 ac

1 ac for irrigation
temp control
& flood harvest

~~PER. # 30926 PRIMARY~~ ~~PER. # 32008~~
~~PER. # 30926 SUPPLEMENTAL~~

~~FINAL PROOF SURVEY~~
UNDER

total 19.1 ac

~~41401~~ ~~30926~~
Application No. ~~12825~~ Permit No. ~~32008~~

IN NAME OF

RODERICK J. NIELSON

Surveyed MAY 17 1969, by W. J. RUPPERT

Revised Application # 59907

WATER RESOURCES DEPT

OCT 23 1980

RECEIVED