

Permit: S 45764
Volume: 6B
Strm: A SPRING
Trib: MUNGERS CREEK
Priority: 4/21/81

UNITED STATES
DEPARTMENT OF THE INTERIOR
BUREAU OF LAND MANAGEMENT

SECTION

25


SW 1/4 NE 1/4

Oregon State Water Filings

TOWNSHIP 38S., RANGE 6W., W. M.

RECEIVED

JUN 23 1981

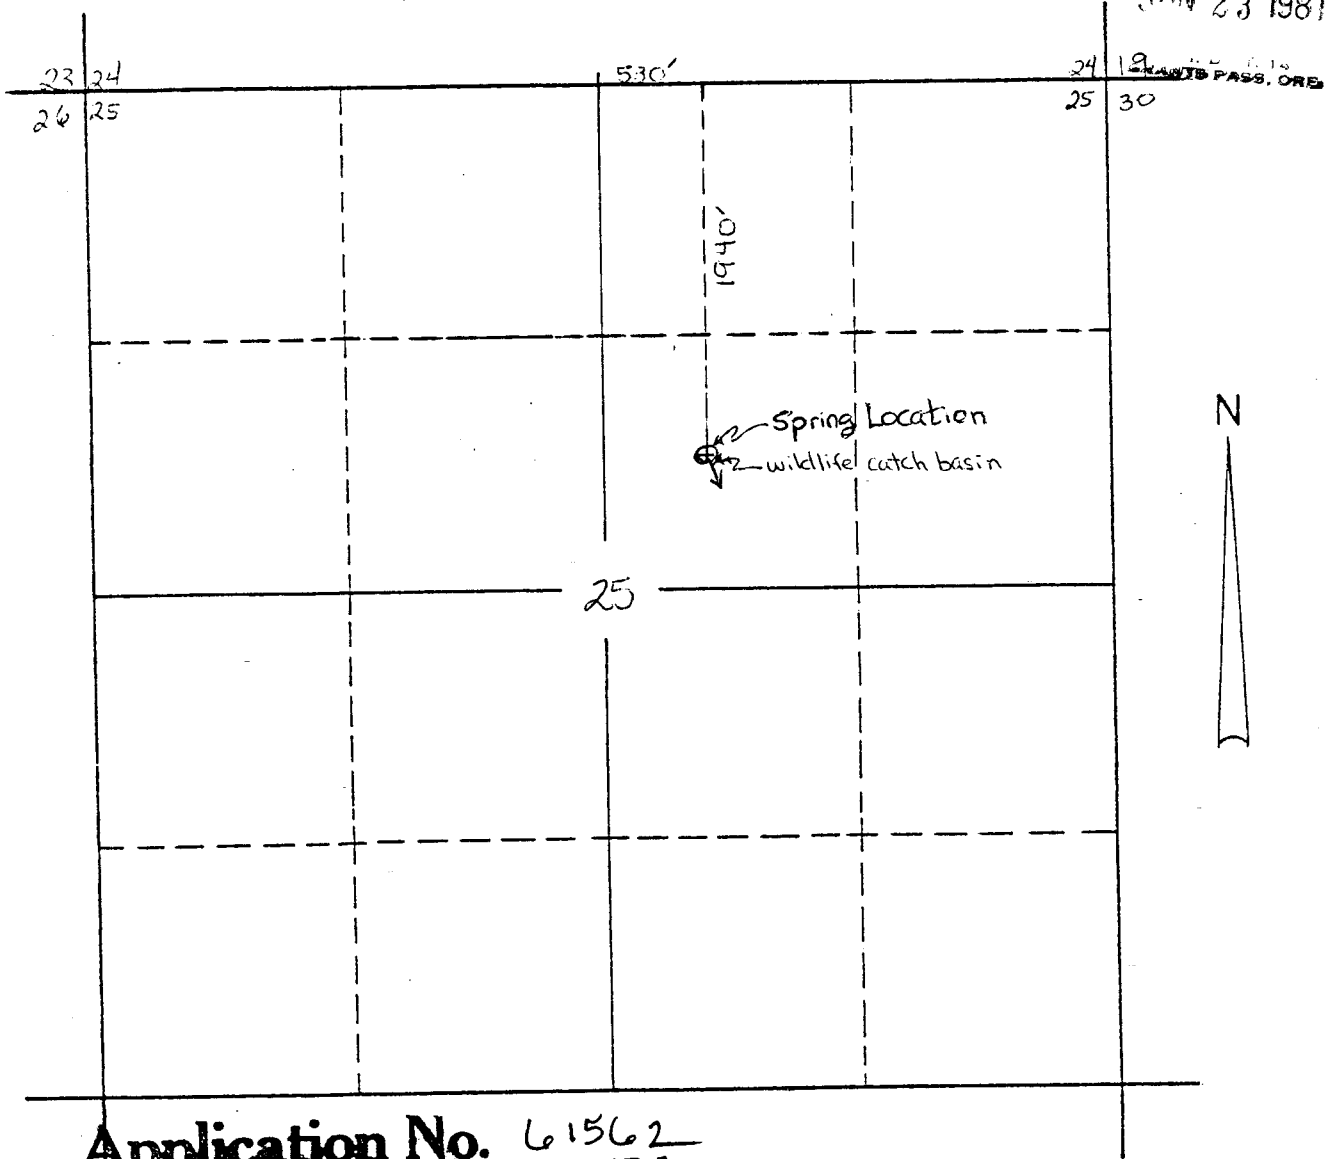

Application No. 61562

Permit No. 45764

SCALE: 1" = 1000'

RECEIVED

APR 21 1981

WATER RESOURCES DEPT
SALEM, OREGON