

RECEIVED

FEB 24 1981

WATER RESOURCES DEPT
SALEM, OREGON

RECEIVED

APR 10 1981


WATER RESOURCES DEPT
SALEM, OREGON

RECEIVED

MAY 15 1979

WATER RESOURCES DEPT.
SALEM, OREGON

SEC 17
T25 R3E W.M.

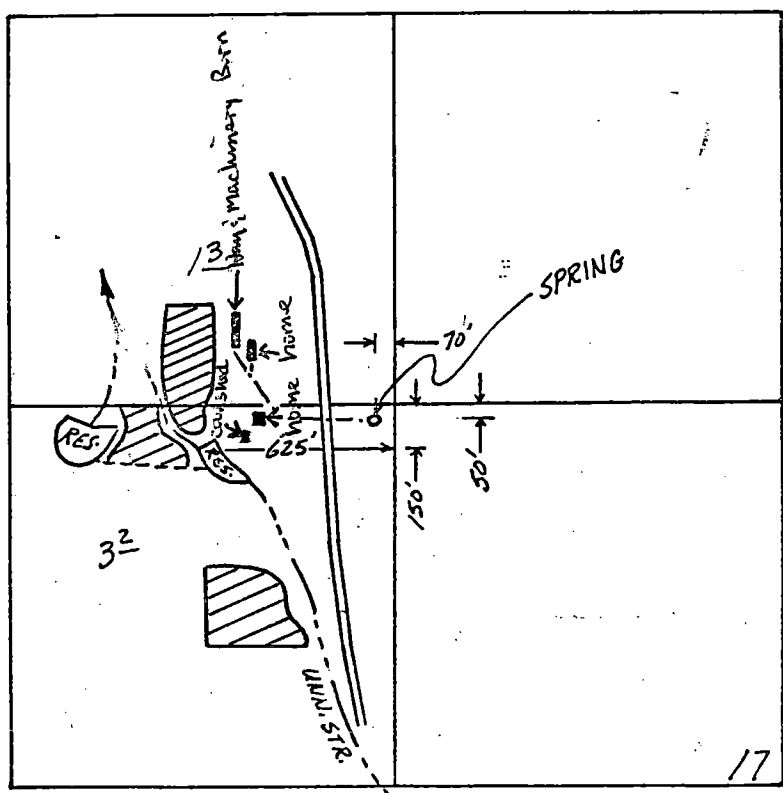

Application No. 58669 & R. 58668
Permit No. 45852 R 8278