
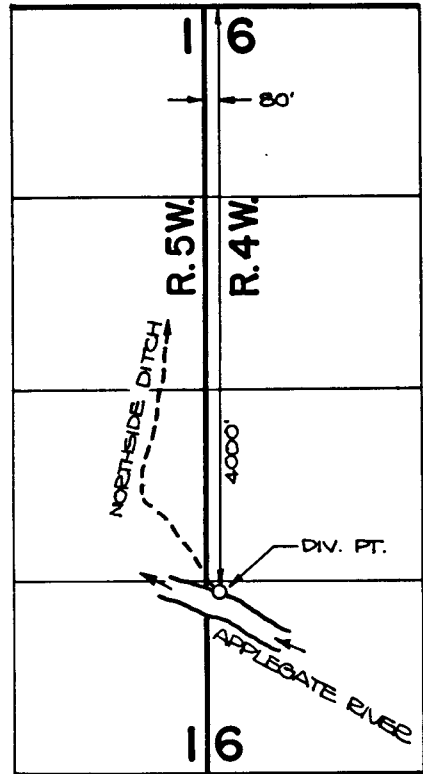


T.37S., R.5W., W.M.

T.38S., R.4 & 5W., W.M.

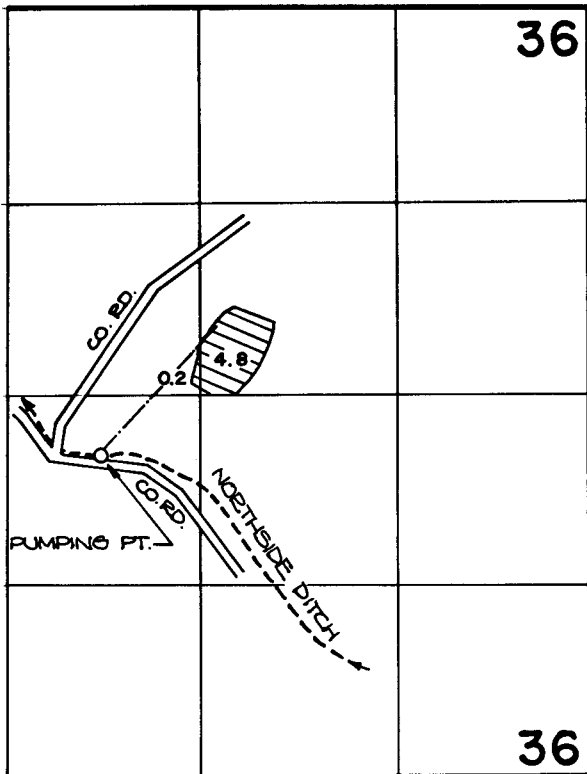

FINAL PROOF SURVEY
UNDER

Application No. **61894** Permit No. **45884**
58813 ... **44328**...

IN NAME OF
R. B. HODGE

Surveyed **AUG. 18, 1983**, by **B. JAMES**

RECEIVED

DEC 17 1986

CO. DIST. 14
GRANTS PASS, ORE.