


T. 37 S., R. 6 W., W. M.

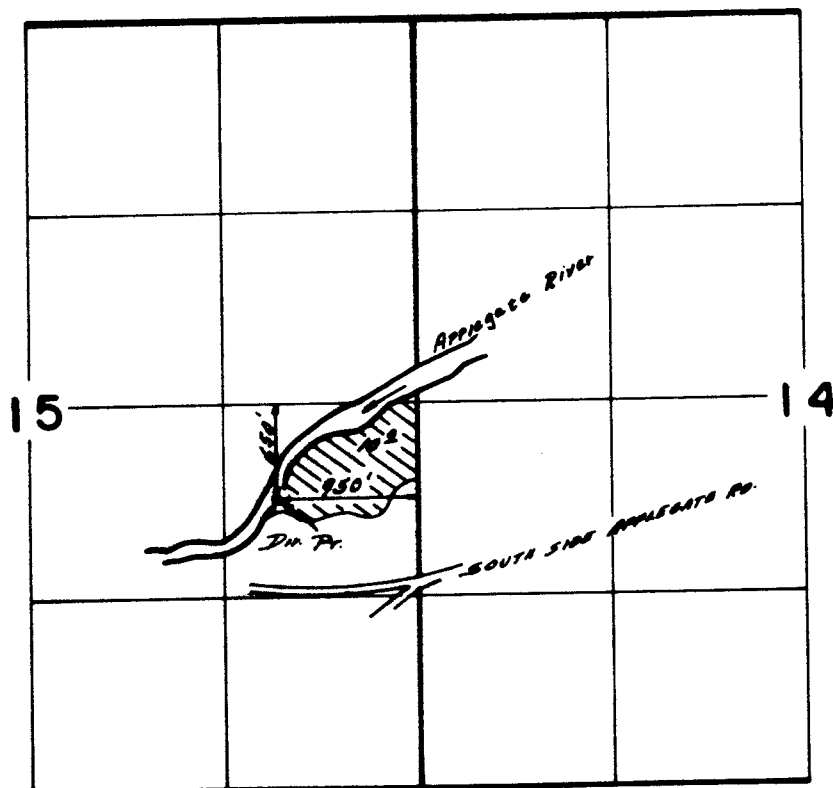

Scale: 1" = 1320'

JUN 8 1988

WM. DIST. 14
GRANTS PASS, OR.

FINAL PROOF SURVEY
UNDER

Application No. **61922**. Permit No. **45890**..
IN NAME OF

INEZ, SCOTT, & BARBARA HASSETT

Surveyed **JUL. 29. 1986**, by **B. S. JAMES**...

B50-2-6 641