


Application No. 61923
Permit No. 45891

RECEIVED

JUL 17 1981

WATER RESOURCES DEPT
SALEM, OREGON

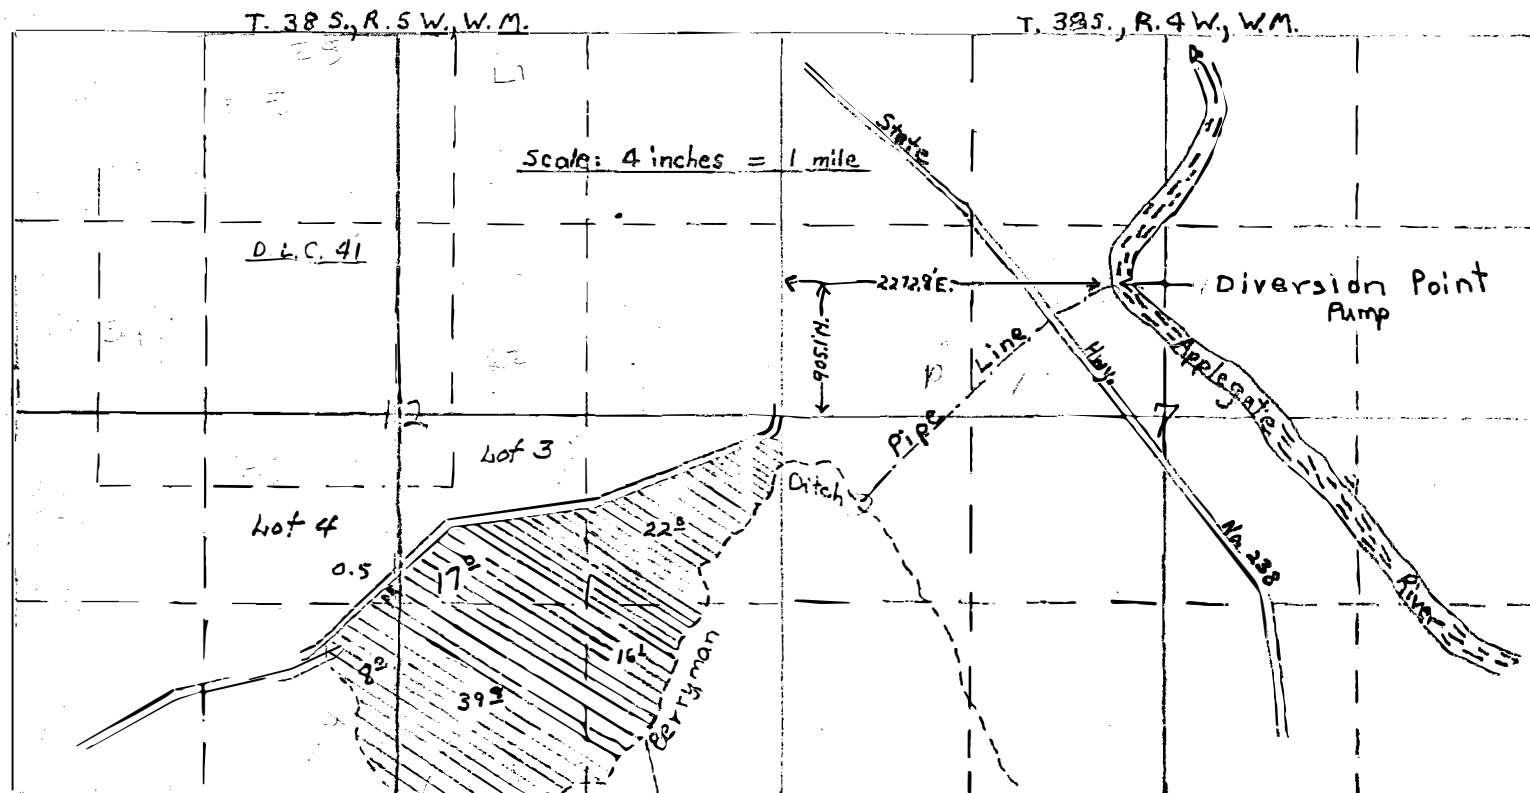

Map to accompany application of
John Sakraida and or Gertrude Sakraide
for supplemental irrigation
water from the Applegate River.