


Josephine

RECEIVED

T. 37 S., R. 6 W., W.M.

MAR 23 1984

WM. DIST. 14
GRANTS PASS, ORE.

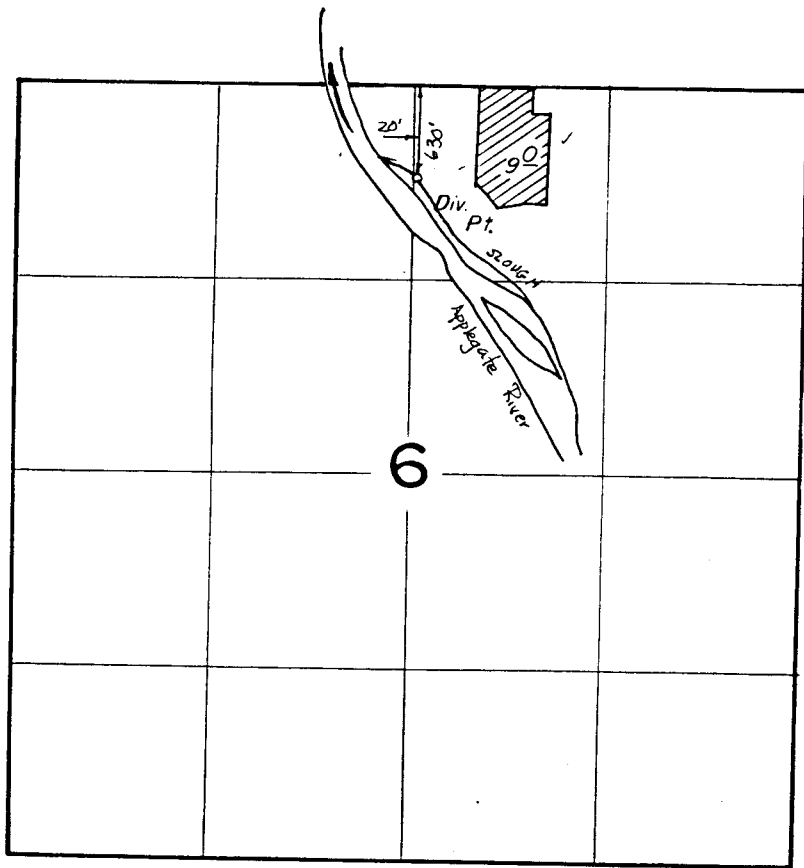

SCALE: 4" = 1 MILE

~~FINAL PROOF SURVEY~~
UNDER

TRANSFER NO. 3928

Application No. 61840.. Permit No. 45934....

IN NAME OF

JEAN MOUNT & T. NIK TAYLOR

Surveyed AUG. 11, 1982, by B. S. JAMES....

B50-3-11