


# T. 38 S., R. 7 W., W. M.

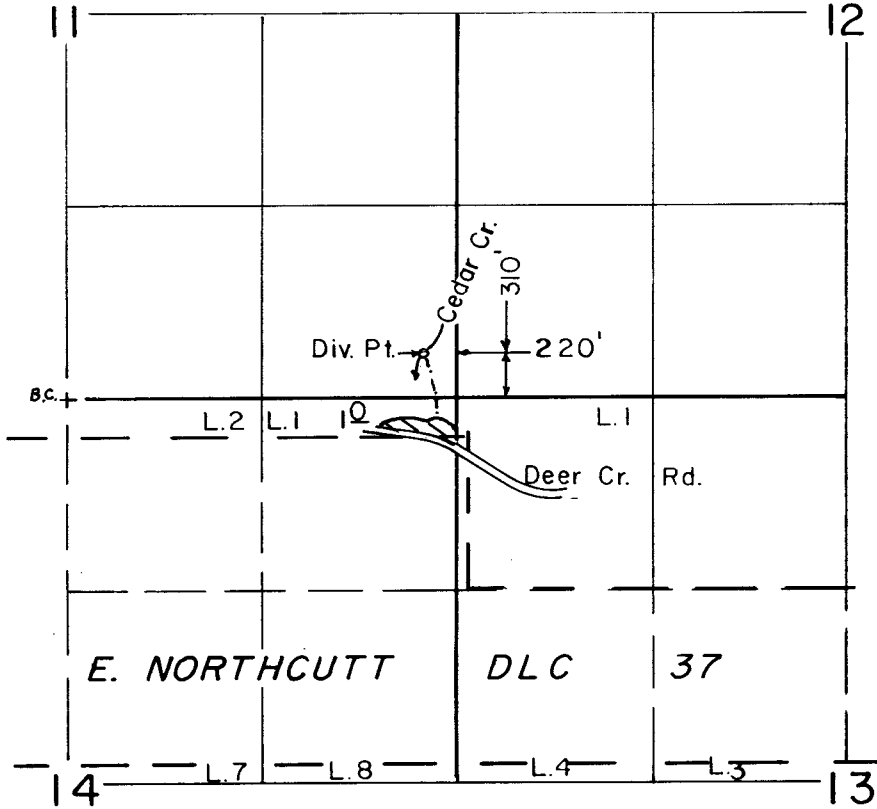

Scale: 1" = 1320'

## FINAL PROOF SURVEY UNDER

Application No. 61864... Permit No. 45935...  
IN NAME OF

.....STEVEN.....OWEN.....

Surveyed MAY 25 1988, by B.S. JAMES.....