
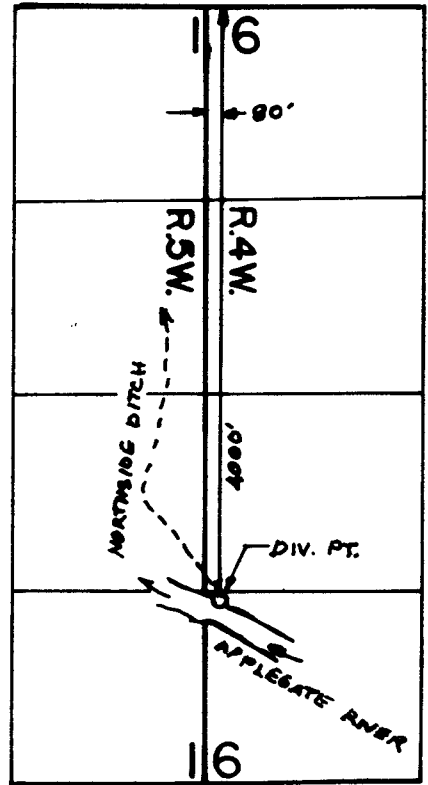


T.37S., R.5W., W.M.

T.38S., R.4&5W., W.M.

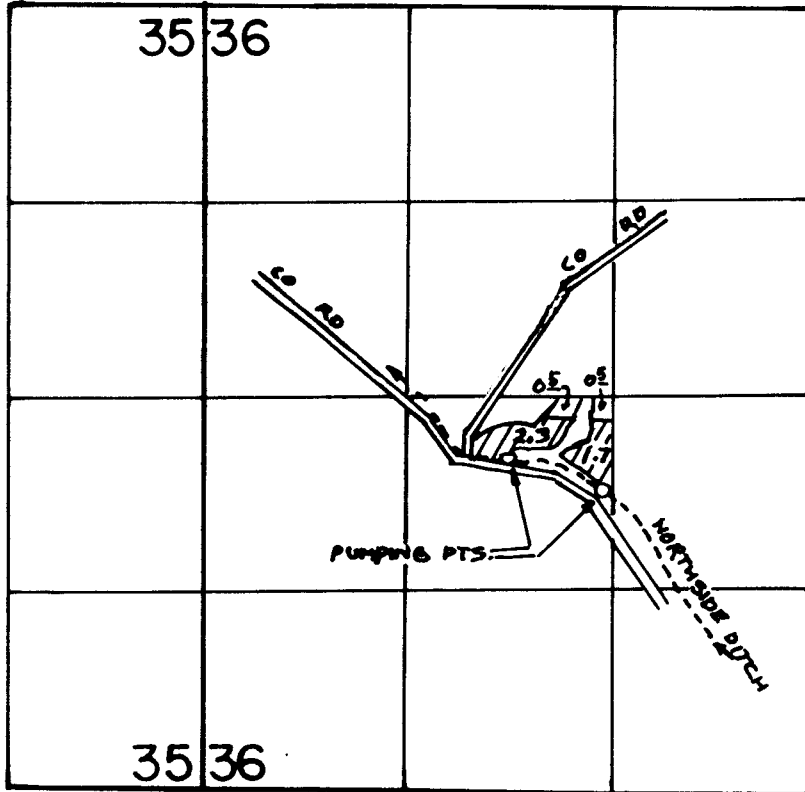

SCALE = 1" = 1920'

### FINAL PROOF SURVEY UNDER

Application No. 61918.. Permit No. 45937...  
IN NAME OF

.....JAMES G. & JULIA M..... BEGG.....

Surveyed NOV. 11... 1984., by ..B.S. JAMES.....

RECEIVED  
SEP 4 1990  
WM. DIST. 14  
GRANTS PASS. ORE

91023-179-110R

6-22-97 DM