

RECEIVED

AUG 9 1981

WATER RESOURCES DEPT
SALEM, OREGON



S. 27

RECEIVED

MAY 13 1981

WATER RESOURCES DEPT
SALEM, OREGON

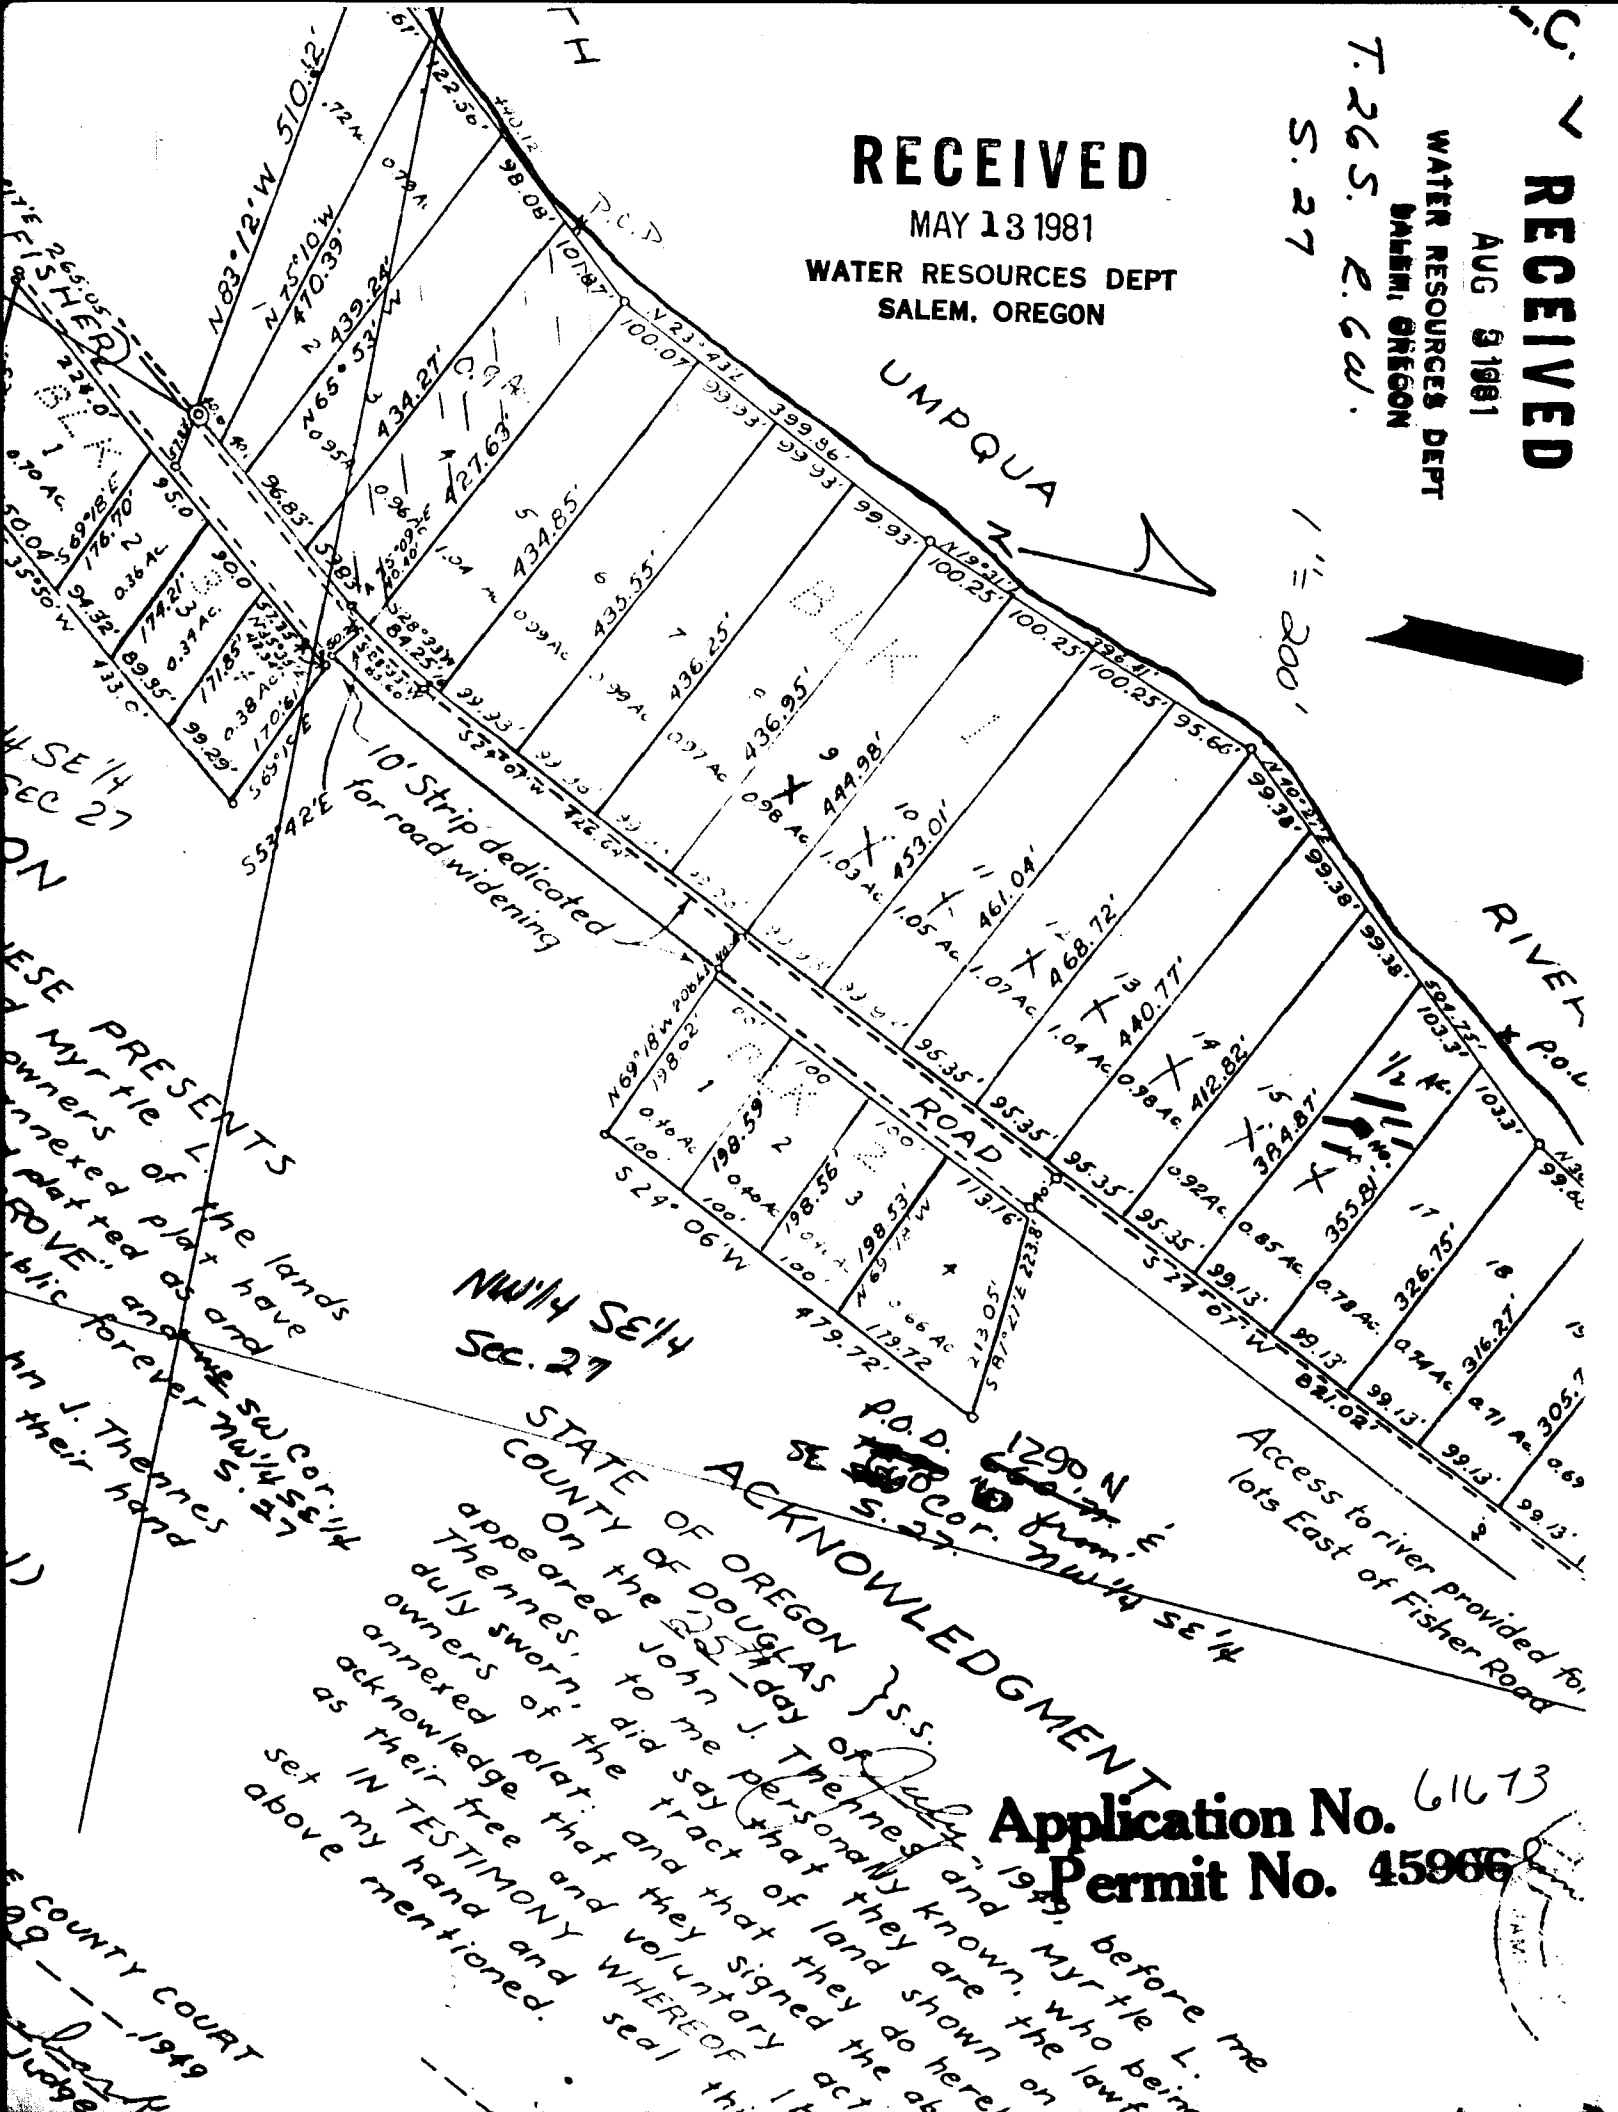

THESE PRESENTS
 owners of the lands
 annexed plat and
 plat as and
 ROVE and
 public forever
 J. Theunes
 their hand

NW 1/4 SE 1/4
 SEC. 27

STATE OF OREGON } S.S.
 COUNTY OF DOUGLAS }
 On the 25th day of July, 1979, before me
 appeared John J. Theunes and Myrtle L. Theunes,
 owners of the tract of land shown on
 duly sworn plat, and they signed the above
 annexe and they voluntarily act
 as their free and voluntary act
 IN TESTIMONY WHEREOF I have set
 above mentioned.

ACKNOWLEDGMENT
 P.O.D. 1290 N
 SE 1/4 Cor. NW 1/4 SE 1/4
 S. 27

Access to river provided for
 lots East of Fisher Road

Application No. 61613
 Permit No. 45966

COUNTY COURT
 Judge