


T. 9S., R. 39E., W. M.

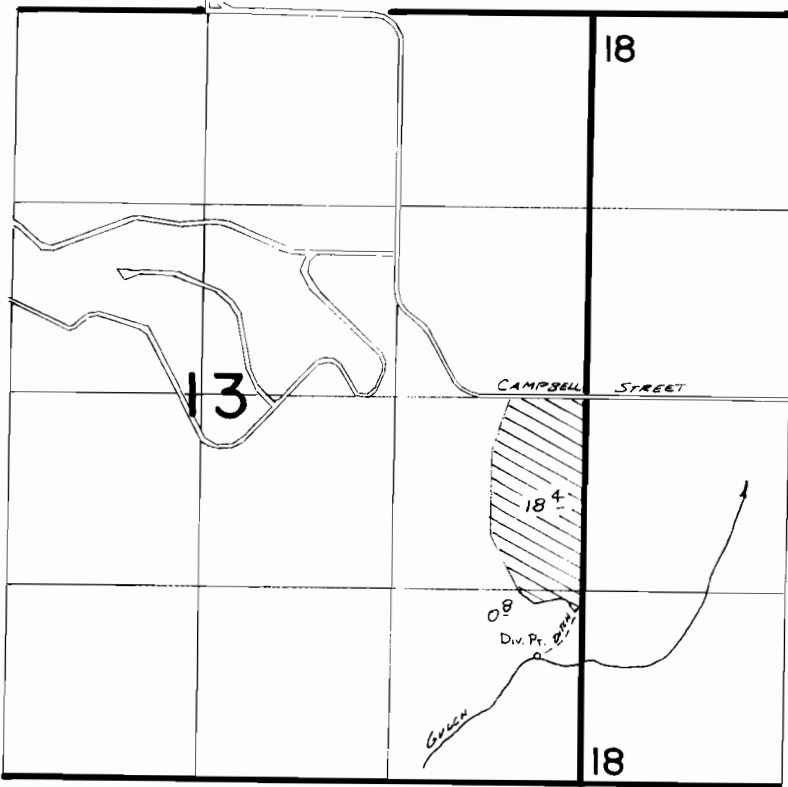

DIV. PR. LOCATED 860' N. & 300' W. FROM SE COR. SEC. 13

FINAL PROOF SURVEY
UNDER

Application No. **7267**..... Permit No. **4599**.....
IN NAME OF

.....**WARNOCK RANCHES, INC.**.....

Surveyed July...12... 1983, by *V.L. Church*.....