

Application No. 61906  
Permit No. 45991

RECEIVED

JUL 15 1981


WATER RESOURCES DEPT. 10  
SALEM, OREGON

10 11  
13 14  
E 789,089  
E 1,368,088




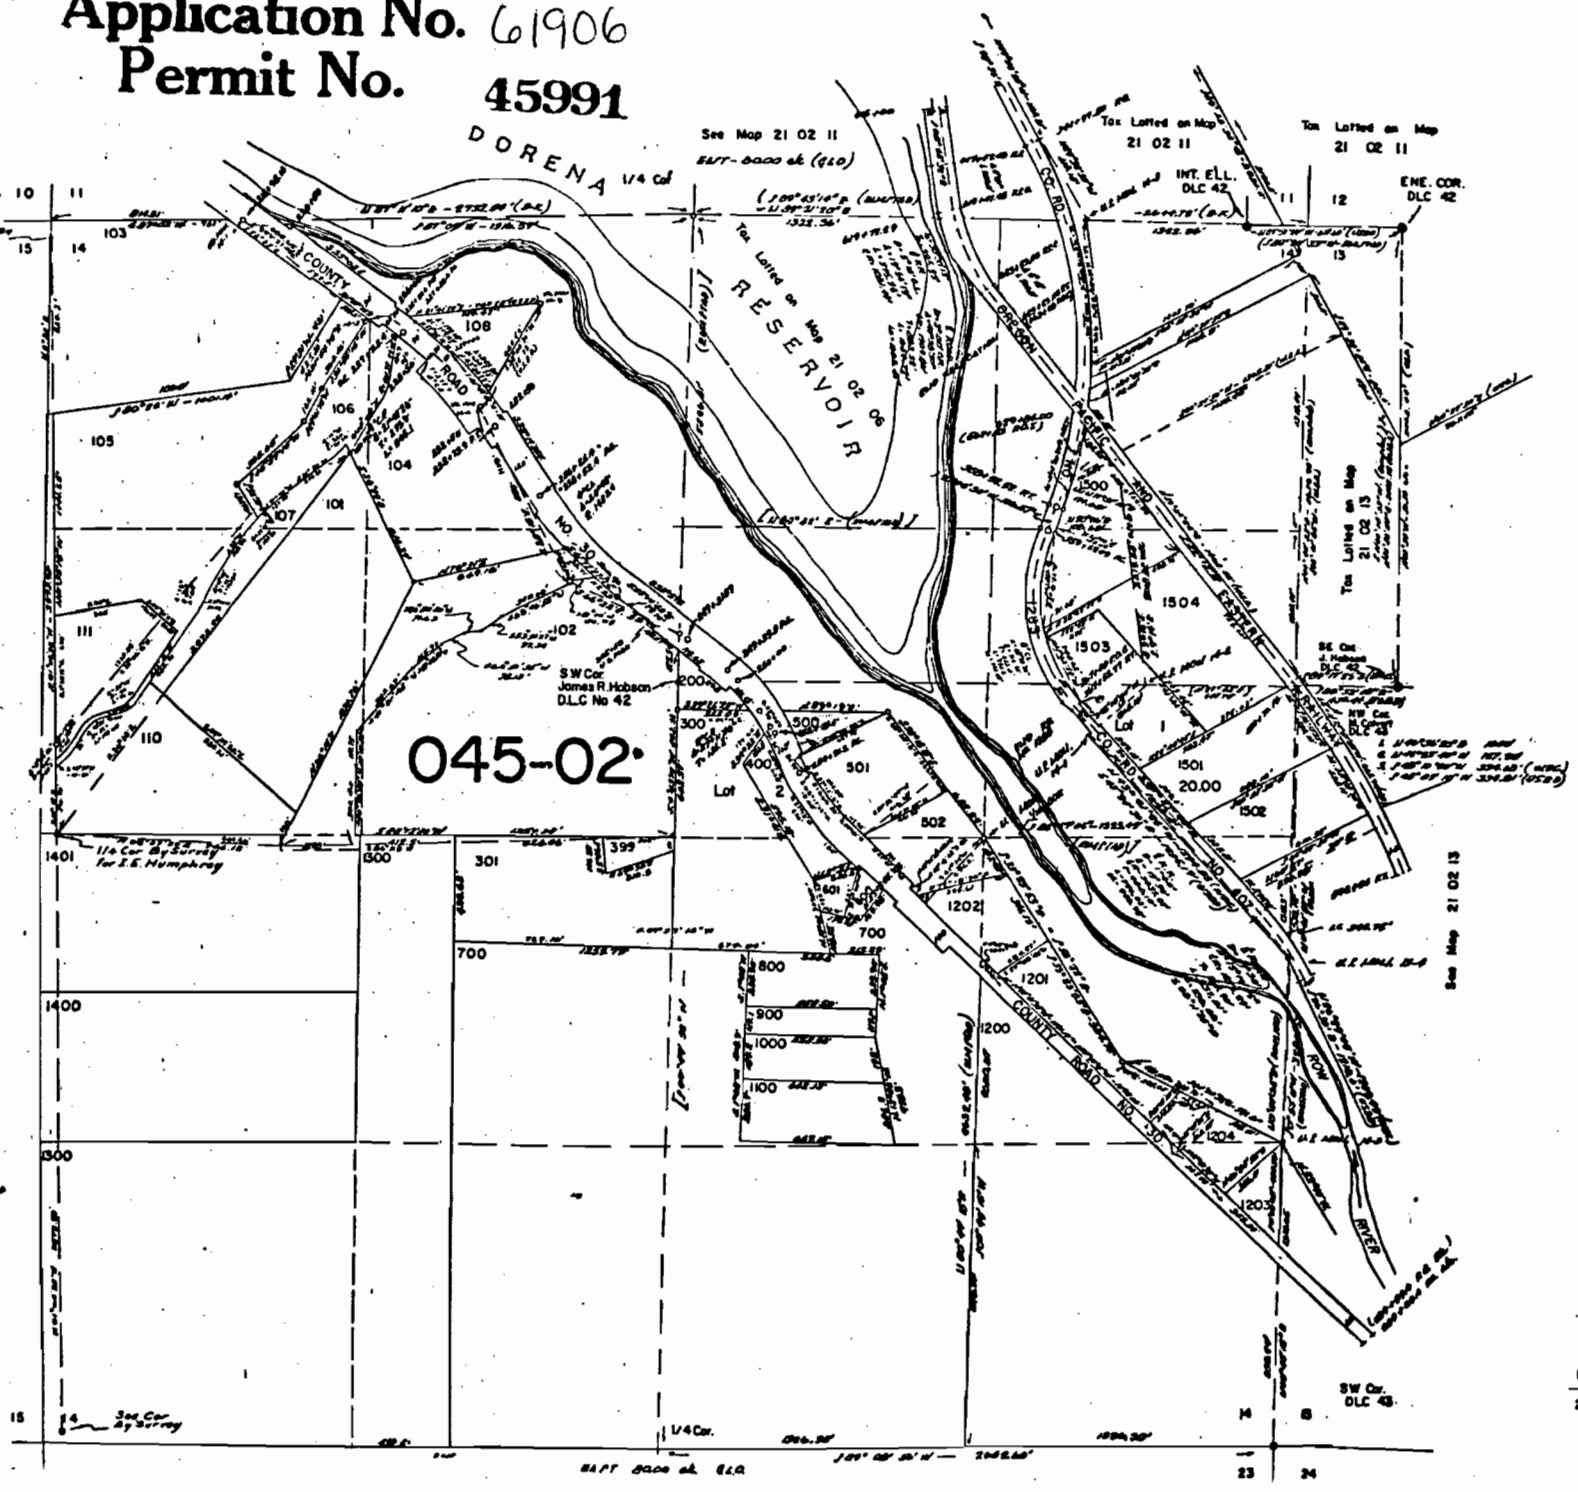

See Map 21 02

See Map 21 02 15

See Cor. by Survey

SW Cor. DLC 43



23

24

Application No. 61906

Permit No. 45991

T.21 S. R.2 W.W.M.

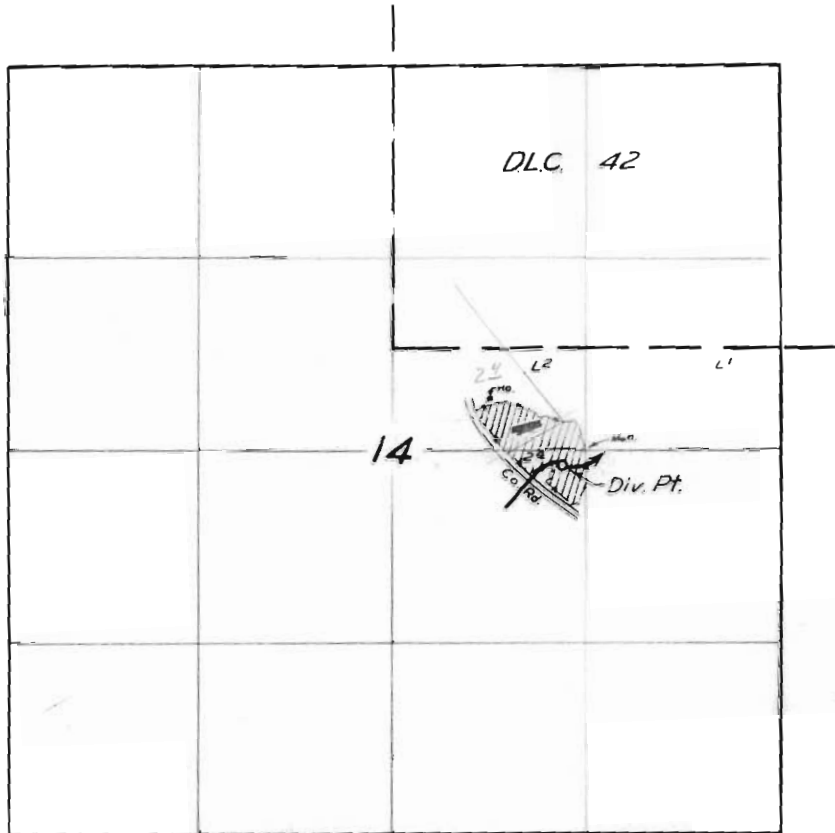

FINAL PROOF SURVEY  
UNDER

Application No. 29826 Permit No. 23460  
IN NAME OF

Ralph O. Warren

Surveyed April 11, 1957, by M. Bish