


T. 38 S., R. 7 W., W. M.

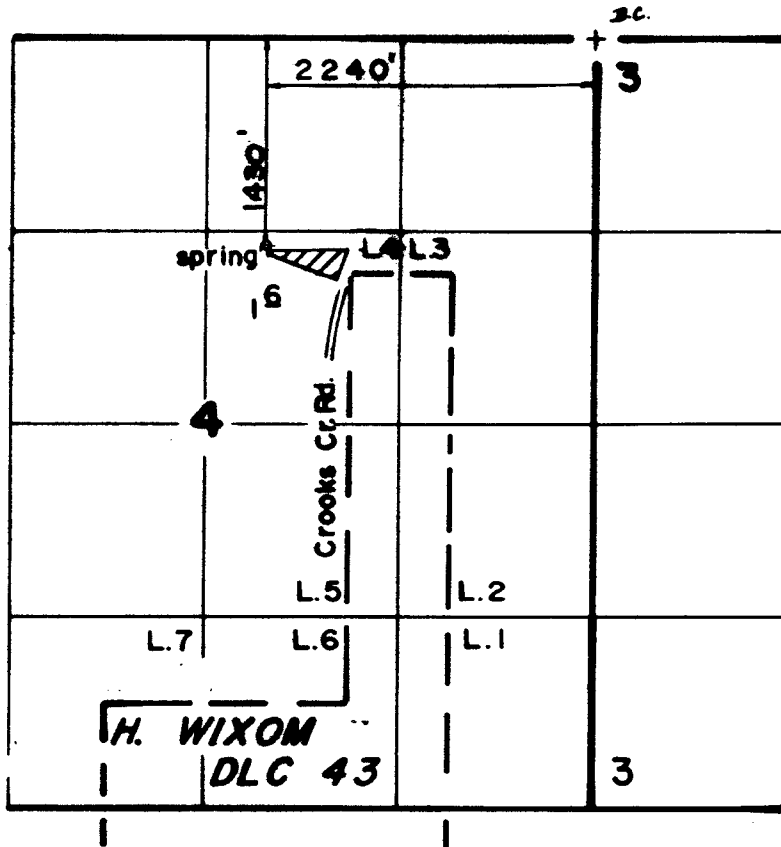

Scale: 1" = 1320'

FINAL PROOF SURVEY
UNDER

Application No. **60075** Permit No. **46005**
IN NAME OF

LEWIS A. MOREY

Surveyed **JUN. 19** 1986, by **R. S. JAMES**

JUN 3 1998

WAL. DIST. 14
GRANT'S PASS, ORE.