


TWP. 35 S. R. 6 W.

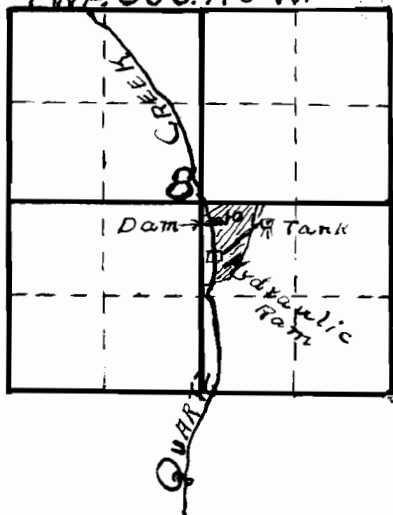

Application No. 7278
Permit No. 4601