


T. 37 S., R. 5 W., W. M.

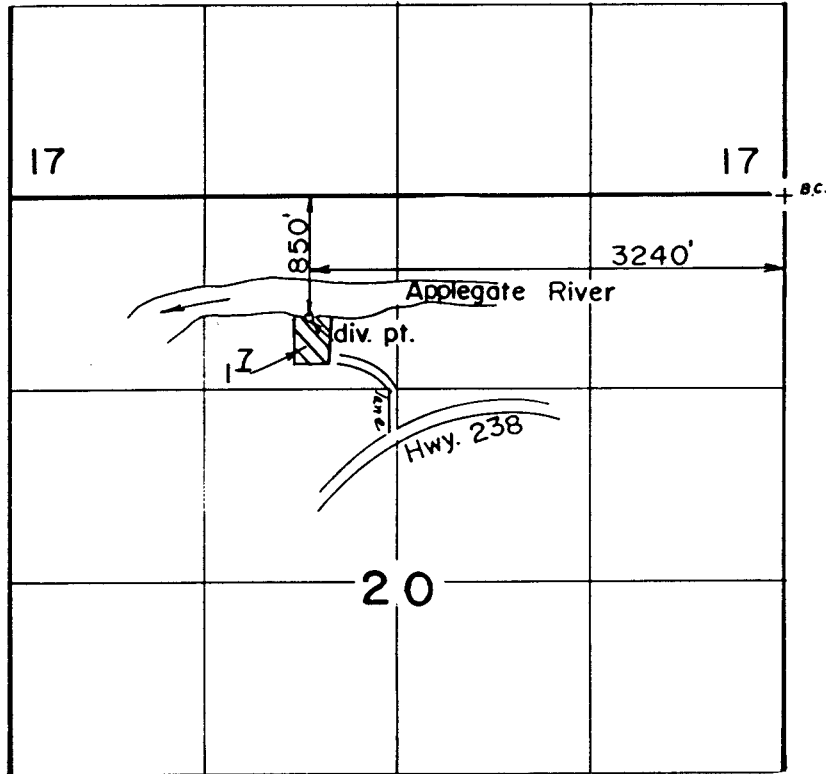

Scale: 1" = 1320'

RECEIVED

APR 24 1991

WM. DIST. 14  
GRANTS PASS, ORE.

**FINAL PROOF SURVEY**  
UNDER

61818                      46015  
Application No. 61819 Permit No. 46016  
IN NAME OF

.....GERALD D. PANKS.....

Surveyed APR. 4 1988, by L. M. JOACHIMS